

JACKSON
D2059

MISSISSIPPI
BOARD OF WATER COMMISSIONERS
416 North State Street
Jackson, Mississippi 39201

WATER WELL DRILLERS LOG

7-23 1984 date well completed
Pierce Drilling Co. Jackson firm name
County well located


LANDOWNER: Adams
Davis sawmill Rd.
Kenedale, MS
(mailing address)

description of formations encountered	from	to
top soil	0	10
clay	10	120
good sand	120	140

WELL LOCATION:
sec. 1 T 4 N R 5 E
1 miles West of Haskett
(distance) (direction) (nearest town)

WELL PURPOSE:
(home, irrigation, municipal, industrial)

- WELL COMPLETION DATA:
- (1) diameter (inches) 2"
 - (2) total depth (feet) 140'
 - (3) static water level (feet) 45' ^{below} above top of ground.
 - (4) casing plastic, 135' (material) (depth)
 - 0 (size) if telescope see back.
 - (5) screen 5' 140' (length) (depth to top)
 - 806, plastic (size) (material)
 - (6) pump 1 10 (HP) (yield gpm)
 - electric (type power)
 - (7) electric log (yes or no)
 - (organization running log)
 - (8) how well bottom plugged Bu

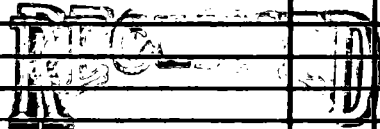


AUG 11 1986

DRILLERS REMARKS:

Department of Natural Resources
Bureau of Land & Water Resources

If well telescopes please sketch and show depths.

GROUND LEVEL

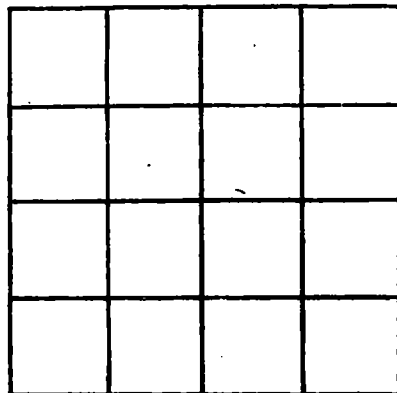

SECTION _____

Please indicate well location X.

ADDITIONAL INFORMATION

If more than one screen, show locations of each on sketch.