

Jackson
D 2061

MISSISSIPPI DEPARTMENT OF NATURAL RESOURCES
Bureau of Land and Water Resources
Southport Mall
P.O. Box 10631
Jackson, Mississippi 39209
WATER WELL DRILLERS LOG

9-30-86 date well completed
Peice Drilling Co. firm name
Jackson county well located

LANDOWNER: H. Hubble

description of formations encountered	from	to
	200 Soil	0
Sand & Clay	10	20
good Sand	20	45


Hurley, MS (mailing address)

WELL LOCATION:
sec. 32 T 4 N R 5 E
S W
miles (distance) of Hurley (nearest town)

WELL PURPOSE:
(home, irrigation, municipal, industrial)

- WELL COMPLETION DATA:
- (1) diameter (inches) 2"
 - (2) total depth (feet) 45'
 - (3) static water level (feet) 18' below top of ground
 - (4) casing (material) plastic, (depth) 40'
 - (size) 0 if telescope see back.
 - (5) screen (length) 5', (depth to top) 45'
 - (size) 006, (material) plastic
 - (6) pump (HP) 1, (yield gpm) 12
electric (type power)
 - (7) electric log (yes or no)
 - (organization running log)
 - (8) how well bottom plugged BW

DRILLERS REMARKS:

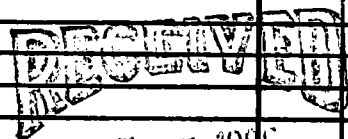

OCT 15 1986

Department of Natural Resources
Bureau of Land & Water Resources

