

MISSISSIPPI DEPARTMENT OF NATURAL RESOURCES

Bureau of Land and Water Resources

Southport Mall

P.O. Box 10631

Jackson, Mississippi 39209  
**WATER WELL DRILLERS LOG**

Jackson  
D 2062

9/27 1980  
 date well completed

Fry Eagle Well  
 firm name

Jackson  
 county well located

LANDOWNER: Roney Scstrat

Hurley, MS

(mailing address)

WELL LOCATION:

sec 31 T 4 N R 5 E  
2 1/2 miles West of Hurley  
 (distance) (direction) (nearest town)

WELL PURPOSE: Flame  
 (home, irrigation, municipal, industrial)

WELL COMPLETION DATA:

- (1) diameter (inches) 2"
- (2) total depth (feet) 320
- (3) static water level (feet) 10 <sup>below</sup> above top of ground.
- (4) casing PVC 310  
 (material) (depth)  
no If telescope see back.  
 (size)
- (5) screen 10' #8 310  
 (length) (depth to top)  
2" PVC  
 (size) (material)
- (6) pump LHC 15  
 (HP) (yield gpm)  
Elect  
 (type power)
- (7) electric log no  
 (yes or no)

(organization running log)

(8) how well bottom plugged PVC  
Ball Check

DRILLERS REMARKS:

description of formations encountered

from to

|                        |     |     |
|------------------------|-----|-----|
| top soil               | 0   | 5   |
| "                      | 5   | 10  |
| sand                   | 10  | 20  |
| sand + clay            | 20  | 40  |
| clay                   | 40  | 44  |
| stone                  | 44  | 100 |
| SAND                   | 100 | 120 |
| Blue Clay, Rock Straps | 120 | 300 |


**RECEIVED**

FEB 27 1987

Department of Natural Resources  
 Bureau of Land & Water Resources

If well telescopes please sketch and show depths.

GROUND LEVEL

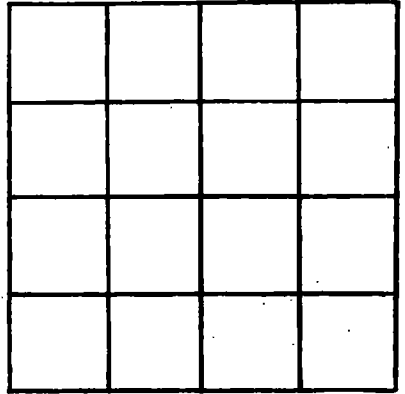

SECTION \_\_\_\_\_

Please indicate well location X.

ADDITIONAL INFORMATION

If more than one screen, show locations of each on sketch.