

MISSISSIPPI DEPARTMENT OF NATURAL RESOURCES

Bureau of Land and Water Resources

Southport Mall

P.O. Box 10631

Jackson, Mississippi 39209

WATER WELL DRILLERS LOG

JACKSON
D 7063

10-26-1986 date well completed De Percin Drilling Co. firm name Jackson county well located

LANDOWNER: Denny Dupree

description of formations encountered

from

to

Harleston Ms
(mailing address)

<u>top soil</u>	<u>0</u>	<u>10</u>
<u>clay</u>	<u>10</u>	<u>15</u>
<u>good sand</u>	<u>15</u>	<u>30</u>
<u>clay</u>	<u>30</u>	<u>170</u>
<u>good sand</u>	<u>170</u>	<u>198</u>

WELL LOCATION:

sec. 17 T. 4 N R. 5 E
1 miles South of Harleston
(distance) (direction) (nearest town)

WELL PURPOSE:

home irrigation, municipal, industrial

WELL COMPLETION DATA:

- (1) diameter (inches) 2"
- (2) total depth (feet) 198'
- (3) static water level (feet) 50' below top of ground.
- (4) casing plastic, 188'
(material) (depth)
0 if telescope see back.
(size)
- (5) screen 10', 198'
(length) (depth to top)
006, plastic
(size) (material)
- (6) pump 1 10
(HP) (yield gpm)
electric
(type power)
- (7) electric log (yes or no)

(organization running log)

(8) how well bottom plugged BW

RECEIVED


SEP 15 1987

Department of Natural Resources
Bureau of Land & Water

DRILLERS REMARKS:

If well telescopes please sketch and show depths.

GROUND LEVEL

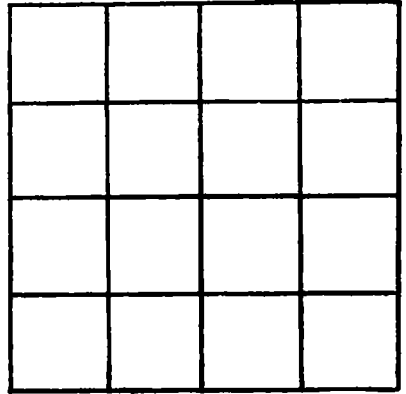

SECTION _____

Please indicate well location X.

ADDITIONAL INFORMATION

A series of horizontal lines for recording additional information, starting below the 'ADDITIONAL INFORMATION' header and extending to the bottom of the page.

If more than one screen, show locations of each on sketch.