

MISSISSIPPI DEPARTMENT OF NATURAL RESOURCES

Bureau of Land and Water Resources

Southport Mall

P.O. Box 10631

Jackson, Mississippi 39209

WATER WELL DRILLERS LOG

Jackson
D 2064

11-6 1986 de Price Drilling Co. Jackson
date well completed firm name county well located

LANDOWNER: Eugene Lambert
Robert Lee Farm
Hurley Ms
(mailing address)

description of formations encountered	depth	
	from	to
<u>top soil</u>	<u>0</u>	<u>10</u>
<u>clay</u>	<u>10</u>	<u>20</u>
<u>good sand</u>	<u>20</u>	<u>40</u>

WELL LOCATION:
sec. 29 T 4 N R 5 E
2 miles North of Hurley
(distance) (direction) (nearest town)

WELL PURPOSE:
home irrigation, municipal, industrial

WELL COMPLETION DATA:

(1) diameter (inches) 2"

(2) total depth (feet) 40'

(3) static water level (feet) 20' below top of ground

(4) casing plastic, 35'
(material) (depth)

P If telescope see back.
(size)

(5) screen 5', 40'
(length) (depth to top)


006, plastic
(size) (material)

(6) pump 1 (HP) 10 (yield gpm)
electric
(type power)

(7) electric log (yes or no)

(organization running log)

(8) how well bottom plugged BW

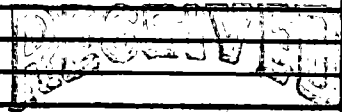

SEP 13 1987

Department of Natural Resources
Bureau of Land & Water Resources

DRILLERS REMARKS:

