

MISSISSIPPI DEPARTMENT OF NATURAL RESOURCES

Bureau of Land and Water Resources

Southport Mall

P.O. Box 10631

Jackson, Mississippi 39209

WATER WELL DRILLERS LOG

Jackson  
D 2065

1-10-1987  
date well completed

87 Pierce Drilling Co.  
firm name

Jackson  
county well located

LANDOWNER: Carl Ellers

description of formations encountered

from to

Hurley, Ms  
(mailing address)

top soil	0	10
clay	10	20
good sand	20	45

WELL LOCATION:

sec 29 T 4 N R 5 E  
 1/2 miles West of Hurley  
 (distance) (direction) (nearest town)

WELL PURPOSE:

home Irrigation, municipal, industrial

WELL COMPLETION DATA:

- (1) diameter (inches) 2"
- (2) total depth (feet) 45'
- (3) static water level (feet) 20' below top of ground.
- (4) casing plastic, 40'  
(material) (depth)
- 0 If telescope see back.  
(size)
- (5) screen 5', 45'  
(length) (depth to top)
- 006, plastic  
(size) (material)
- (6) pump 1 10  
(HP) (yield gpm)
- electric  
(type power)
- (7) electric log yes or no

(organization running log)

(8) how well bottom plugged BW

RECEIVED


SEP 15 1987

DRILLERS REMARKS:

Department of Natural Resources  
Bureau of Land & Water Resources

If well telescopes please  
sketch and show depths.

GROUND LEVEL

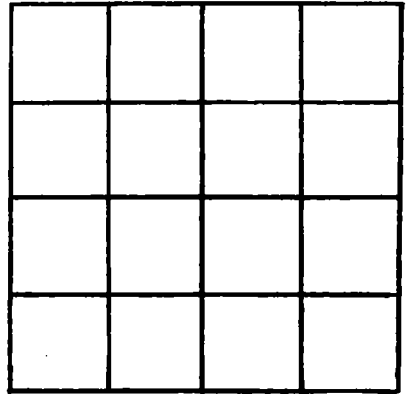

SECTION \_\_\_\_\_

Please indicate well location X.

ADDITIONAL INFORMATION

If more than one screen,  
show locations of each on sketch.