

MISSISSIPPI DEPARTMENT OF NATURAL RESOURCES

Bureau of Land and Water Resources

Southport Mall

P.O. Box 10631

Jackson, Mississippi 39209

WATER WELL DRILLERS LOG

JACKSON
D 2066

2-20 date well completed

1987 Peirce Drilling Co. firm name

Jackson county well located

LANDOWNER: Johnny Harmore

description of formations encountered

from

to

Hurley, Ms (mailing address)

top soil	0	10
clay	10	18
good sand	18	30

WELL LOCATION:

sec 7 T 4 N R 5 E
1 miles South of Hareston
(distance) (direction) (nearest town)

WELL PURPOSE:

(Home, Irrigation, municipal, industrial)

WELL COMPLETION DATA:

- (1) diameter (inches) 2"
- (2) total depth (feet) 30'
- (3) static water level (feet) 14' ^{below} top of ground
- (4) casing plastic, 25' (material) (depth)
0 (size) If telescope see back.
- (5) screen 5' 30' (length) (depth to top)
006 plastic (size) (material)
- (6) pump 1 12 (HP) (yield gpm)
electric (type power)
- (7) electric log (yes or no)
- (organization running log)
- (8) how well bottom plugged BW

DECEMBER 15 1987


SEP 15 1987

Department of Natural Resources
Bureau of Land and Water Resources

DRILLERS REMARKS:

If well telescopes please
sketch and show depths.

GROUND LEVEL

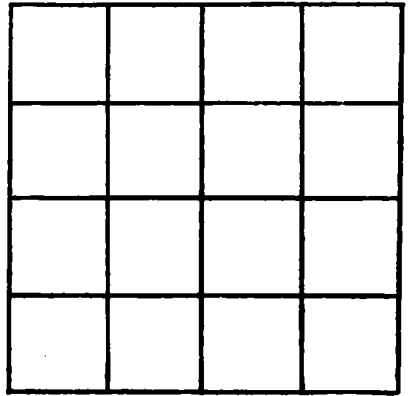

SECTION _____

Please indicate well location X.

ADDITIONAL INFORMATION

If more than one screen,
show locations of each on sketch.