

MISSISSIPPI DEPARTMENT OF NATURAL RESOURCES
Bureau of Land and Water Resources
 Southport Mall
 P.O. Box 10631
 Jackson, Mississippi 39209
WATER WELL DRILLERS LOG

Jackson
D 2068

3-15-87 Price Drilling Co Jackson
 date well completed firm name county well located

LANDOWNER: Gerald Neremore
Hurley, Ms
 (mailing address)

description of formations encountered	from	to
<u>Top Soil</u>	<u>0</u>	<u>10</u>
<u>Clay</u>	<u>10</u>	<u>20</u>
<u>gavel sand</u>	<u>20</u>	<u>45</u>

WELL LOCATION:
 sec. 29 T 4 N R. 5 E
 (S) (W)
1 miles West of Hurley
 (distance) (direction) (nearest town)

WELL PURPOSE:
(home) irrigation, municipal, industrial

WELL COMPLETION DATA:

(1) diameter (inches) 2"
 (2) total depth (feet) 45'
 (3) static water level (feet) 15' below above top of ground.
 (4) casing plastic, 40'
 (material) (depth)
0 If telescope see back.
 (size)
 (5) screen 5', 45'
 (length) (depth to top)
006, plastic
 (size) (material)
 (6) pump 1 12
 (HP) (yield gpm)
electric
 (type power)
 (7) electric log (yes or no)
 (organization running log)
 (8) how well bottom plugged BW

RECEIVED


SEP 15 1987

Department of Natural Resources
 Bureau of Land & Water Resources

DRILLERS REMARKS:

If well telescopes please sketch and show depths.

GROUND LEVEL

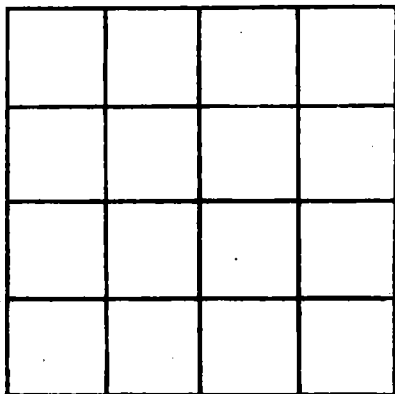

SECTION _____

Please indicate well location. X.

ADDITIONAL INFORMATION

If more than one screen, show locations of each on sketch.