

MISSISSIPPI DEPARTMENT OF NATURAL RESOURCES

Bureau of Land and Water Resources

Southport Mall

P.O. Box 10631


Jackson, Mississippi 39209

WATER WELL DRILLERS LOG

JACKSON
D 2069

3-25-1987 date well completed Pierce Drilling Co. firm name Jackson county well located

LANDOWNER: <u>Buddy Broome</u>	description of formations encountered	from	to
<u>Husky, Ms</u> (mailing address)	<u>top soil</u> <u>clay</u> <u>good sand</u>	0 10 20	10 20 40
WELL LOCATION: sec. <u>18</u> T <u>4</u> N R <u>5</u> E <u>2</u> miles <u>South</u> of <u>Navelton</u> (distance) (direction) (nearest town)			
WELL PURPOSE: (<u>home</u> , irrigation, municipal, industrial)			
WELL COMPLETION DATA:			
(1) diameter (inches) <u>2"</u>			
(2) total depth (feet) <u>40'</u>			
(3) static water level (feet) <u>18'</u> <u>below</u> top of ground.			
(4) casing <u>plastic</u> , <u>35'</u> (material) (depth)			
<u>0</u> if telescope see back. (size)			
(5) screen <u>5'</u> , <u>40'</u> (length) (depth to top)			
<u>006</u> , <u>plastic</u> (size) (material)			
(6) pump <u>1</u> <u>12</u> (HP) (yield gpm)			
<u>electric</u> (type power)			
(7) electric log <u>yes</u> or <u>no</u>			
(organization running log)			
(8) how well bottom plugged <u>BW</u>			
DRILLERS REMARKS: <u> </u>			

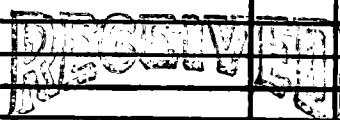

SEP 15 1987

Department of Natural Resources
Bureau of Land & Water Resources

If well telescopes please sketch and show depths.

GROUND LEVEL

SECTION _____

Please indicate well location X.

ADDITIONAL INFORMATION

If more than one screen,
show locations of each on sketch.