

MISSISSIPPI DEPARTMENT OF NATURAL RESOURCES
Bureau of Land and Water Resources
 Southport Mall
 P.O. Box 10631
 Jackson, Mississippi 39209
WATER WELL DRILLERS LOG

Jackson
D 2070

6-17 1987 Purci Drilling Co. Jackson
 date well completed firm name county well located

LANDOWNER: Gene Roberts
Hurley, MS
 (mailing address)


| description of formations encountered | from | to |
|---------------------------------------|-----------|------------|
| <u>Top soil</u> | <u>0</u> | <u>10</u> |
| <u>Sand</u> | <u>10</u> | <u>20</u> |
| <u>Clay</u> | <u>20</u> | <u>80</u> |
| <u>Good Sand</u> | <u>80</u> | <u>105</u> |

WELL LOCATION:
 sec. 19 T. 4 N R. 5 E
2 miles North of Hurley
 (distance) (direction) (nearest town)

WELL PURPOSE:
 (home) Irrigation, municipal, Industrial

- WELL COMPLETION DATA:
- (1) diameter (inches) 2'
 - (2) total depth (feet) 105'
 - (3) static water level (feet) 25' ^{below} _{above} top of ground.
 - (4) casing plastic, 95',
 (material) (depth)
 - 0 if telescope see back.
 (size)
 - (5) screen 10', 105'
 (length) (depth to top)
 - 006, plastic
 (size) (material)
 - (6) pump 1 10
 (HP) (yield gpm)
 - electric
 (type power)
 - (7) electric log (yes or no)
 - (organization running log)
 - (8) how well bottom plugged BW


DRILLERS REMARKS:

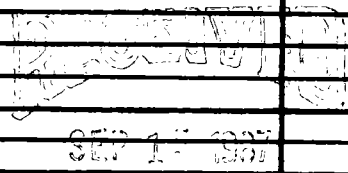

BUREAU OF LAND AND WATER RESOURCES
 MISSISSIPPI DEPARTMENT OF NATURAL RESOURCES

If well telescopes please sketch and show depths.

GROUND LEVEL

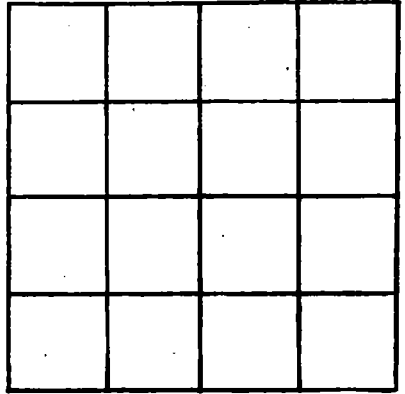

SECTION _____

Please indicate well location X.

ADDITIONAL INFORMATION

If more than one screen, show locations of each on sketch.