

MISSISSIPPI DEPARTMENT OF NATURAL RESOURCES  
 Bureau of Land and Water Resources  
 Southport Mall  
 P.O. Box 10631  
 Jackson, Mississippi 39209  
**WATER WELL DRILLERS LOG**

JACKSON  
 D 2076

1-29-88 19 Sothern Water Well Serv JACKSON  
 date well completed firm name county well located

LANDOWNER: <u>LEROY TRUSSLER</u>	description of formations encountered	from	to
<u>Barrier Rd</u>			
<u>Hurley MS 39555</u> (mailing address)	<u>Sandy Soil</u>	<u>0</u>	<u>20</u>
	<u>Clay</u>	<u>20</u>	<u>35</u>
	<u>Land Scam?</u>	<u>35</u>	<u>50</u>

WELL LOCATION:  
 sec. 32 T. 4 N. R. 5 E.  
 (S) (W)  
1 miles E. of HURLEY  
 (distance) (direction) (nearest town)

WELL PURPOSE:  
 (home, irrigation, municipal, industrial)

- WELL COMPLETION DATA:
- (1) diameter (inches) 2"
  - (2) total depth (feet) 50'
  - (3) static water level (feet) 8' below above top of ground.
  - (4) casing PVC, 45'  
 (material) (depth)
  - N/A if telescope see back.  
 (size)
  - (5) screen 5', 45'  
 (length) (depth to top)
  - 2", PVC  
 (size) (material)
  - (6) pump N/A N/A  
 (HP) (yield gpm)
  - N/A  
 (type power)
  - (7) electric log N/A  
 (yes or no)
  - N/A  
 (organization running log)
  - (8) how well bottom plugged Back-  
wash hole


DRILLERS REMARKS:  
No pump installed

**RECEIVED**  
 FEB 19 1988

Department of Natural Resources  
 Bureau of Land & Water Resources

If well telescopes please sketch and show depths.

GROUND LEVEL

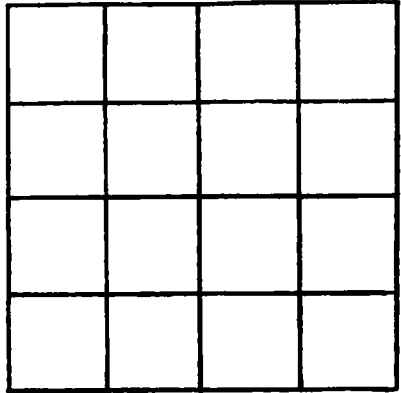

SECTION \_\_\_\_\_

Please indicate well location X.

ADDITIONAL INFORMATION

If more than one screen,  
show locations of each on sketch.