

MISSISSIPPI DEPARTMENT OF NATURAL RESOURCES
Bureau of Land and Water Resources

P.O. Box 10631
Jackson, Mississippi 39209
WATER WELL DRILLERS LOG

COUNTY WELL LOCATED <i>Jackson</i>	
WELL NUMBER <i>D 2099</i>	CODED
DATE WELL COMPLETED <i>10-8-89</i>	

PERMIT NUMBER
NAME OF DRILLING FIRM <i>Pierce Drilling</i>

NAME & MAILING ADDRESS OF LANDOWNER <i>L. Hubbard</i> <i>Harleston</i> <i>Pascagoula, ms</i>			
WELL LOCATION: SEC	TOWNSHIP	RANGE	
<i>4</i>	<i>4</i>	<i>5</i>	<i>E</i> <i>W</i>
DISTANCE <i>1/2</i> Miles	DIRECTION <i>S</i>	NEAREST TOWN <i>George Co. line</i>	
OTHER LANDMARK			
WELL PURPOSE: <input checked="" type="checkbox"/> Home Irrigation, <input type="checkbox"/> Municipal, <input type="checkbox"/> Industrial, <input type="checkbox"/> Fish Pond, etc.			

PUMP DATA		
PUMP TYPE (Circle One): Submersible, Turbine, <input checked="" type="radio"/> Jet, Flowing Well, Other (Describe)		
POWER TYPE (Circle One): <input checked="" type="radio"/> Electric, Tractor, Diesel, Gasoline, Butane, Other (Describe)		
Pump Capacity (GPM) <i>8</i>	No. of Stages <i>Single</i>	Setting Depth <i>20</i> FT.
PUMP TEST		
Well yielded <i>8</i> GPM with a drawdown of <i>5</i> ft. after <i>1</i> hours of pumping		

WELL DATA		
Well Depth <i>38'</i>	Casing Diameter (In.) <i>2"</i>	Casing Length (Ft.) <i>33'</i>
Type of Casing <i>Plastic</i>	Hole Depth <i>38'</i>	Depth to Static Water Level <i>18'</i>
TYPE OF COMPLETION: (Circle One or More): <input checked="" type="checkbox"/> Gravel Packed, <input checked="" type="checkbox"/> Underreamed, <input type="checkbox"/> Telescoped, <input checked="" type="checkbox"/> Natural Development, <input type="checkbox"/> Open Hole, <input type="checkbox"/> Other (Describe)		
Top of Lap Pipe or Reduction in Casing FEET IF TELESCOPED OR MORE THAN ONE SCREEN: USE BACK PAGE		

LOG DATA	
TYPE OF LOG RUN (Circle One): <input checked="" type="radio"/> No Log Run, <input type="radio"/> Electric, <input type="radio"/> Gamma Ray, <input type="radio"/> Density, <input type="radio"/> Sonic, <input type="radio"/> Neutron, Other (Describe)	
Name of Organization Running Log	

SCREEN DATA		
Diameter - Inches <i>2"</i>	Length - Feet <i>5'</i>	Slot Size - Inches <i>006</i>
Screen Type <i>Plastic</i>	Depth to Bottom - Feet <i>38'</i>	

GEOLOGIC DATA (Office Use Only)			
Surface Elev.	Geologic Unit	Unit Thickness	Depth to Top
Subs. SWL	Date	Analysis	Aquifer Test
Driller's Remarks			

DESCRIPTION OF FORMATIONS ENCOUNTERED	FROM	TO	FORMATIONS (Continued)	
			FROM	TO
<i>Top soil</i>	<i>0</i>	<i>10</i>		
<i>Clay</i>	<i>10</i>	<i>20</i>		
<i>Good Sand</i>	<i>20</i>	<i>38</i>		

RECEIVED


OCT 24 1989

Department of Natural Resources
Bureau of Land & Water Resources

IF MORE SPACE IS NEEDED, USE BACK

If well telescopes please
sketch and show depths.

GROUND LEVEL

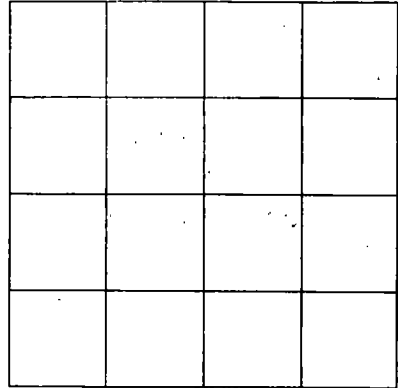

SECTION _____

Please indicate well location X.

ADDITIONAL INFORMATION

If more than one screen,
show location of each on sketch.