

MISSISSIPPI DEPARTMENT OF NATURAL RESOURCES

Bureau of Land and Water Resources

Southport Mall

P.O. Box 10631

Jackson, Mississippi 39209

WATER WELL DRILLERS LOG

Jackson
D 704

10-5-89

Southern Water Well Jackson

date well completed

firm name

county well located

LANDOWNER:

Slater

description of formations encountered

sand

from

to

0 45'

Hurley road Rd
(mailing address)


WELL LOCATION:

sec. 31 T 4 N R 5 E
S W
1 miles W of Hurley
(distance) (direction) (nearest town)

WELL PURPOSE: None
(home, irrigation, municipal, industrial)

WELL COMPLETION DATA:

- (1) diameter (inches) 2'
- (2) total depth (feet) 45'
- (3) static water level (feet) 20' below top of ground.
- (4) casing PVC, 40'
(material) (depth)
(size) if telescope see back.
- (5) screen 5', 40'
(length) (depth to top)
2" PVC
(size) (material)
- (6) pump None
(HP) (yield gpm)
(type power)
- (7) electric log No
(yes or no)
(organization running log)
- (8) how well bottom plugged BWV

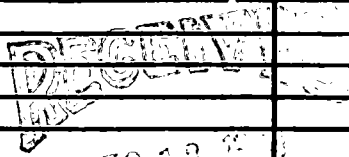


Department of Natural Resources
Bureau of Land and Water Resources

DRILLERS REMARKS:

If well telescopes please sketch and show depths.

GROUND LEVEL

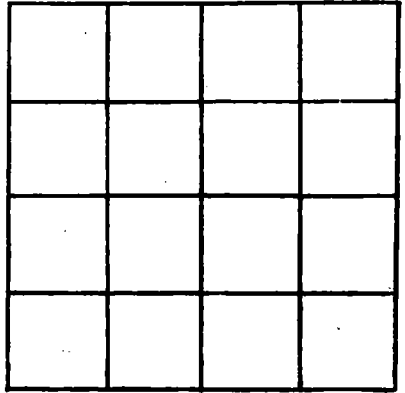

SECTION _____

Please indicate well location X.

ADDITIONAL INFORMATION

If more than one screen,
show locations of each on sketch.