

MISSISSIPPI DEPARTMENT OF NATURAL RESOURCES
Bureau of Land and Water Resources
 Southport Mall
 P.O. Box 10631
 Jackson, Mississippi 39209
WATER WELL DRILLERS LOG

Jackson
P 2100

7-28-91 19 Southern Water Well Jackson
 date well completed firm name county well located

LANDOWNER: McMontgomery
Hwy 614
Hurley
 (mailing address)

description of formations encountered	from	to
<u>slat</u>	<u>0</u>	<u>25</u>
<u>sandst</u>	<u>15</u>	<u>35</u>

WELL LOCATION:
 sec. 2 T. 4 N. R. 5 E.
20 miles N of Monticent
 (distance) (direction) (nearest town)

WELL PURPOSE: Home
 (home, irrigation, municipal, industrial)

- WELL COMPLETION DATA:
- (1) diameter (inches) 2"
 - (2) total depth (feet) 35'
 - (3) static water level (feet) 5 below top of ground. above
 - (4) casing PVC 30'
 (material) (depth)
2"
 (size) if telescope see back.
 - (5) screen 5' 30'
 (length) (depth to top)
2" PVC
 (size) (material)
 - (6) pump 1/2 10
 (HP) (yield gpm)
AC
 (type power)
 - (7) electric log NO
 (yes or no)
 (organization running log)
 - (8) how well bottom plugged BWV

RECEIVED


FEB 19 1991

Dept. of Environmental Quality
 Bureau of Land & Water Resources

DRILLERS REMARKS:

If well telescopes please sketch and show depths.

GROUND LEVEL

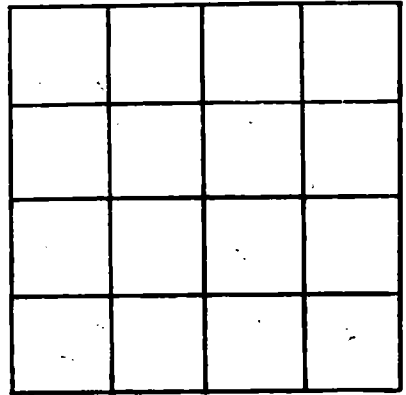

SECTION _____

Please indicate well location X.

ADDITIONAL INFORMATION

If more than one screen,
show locations of each on sketch.