




If well telescopes please sketch and show depths.

GROUND LEVEL

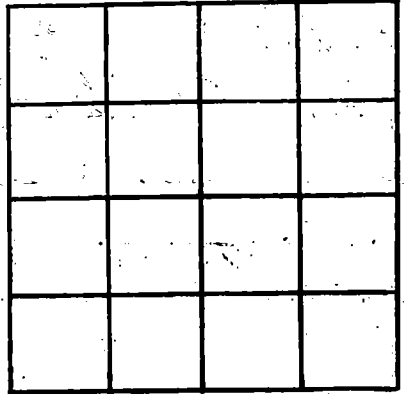

SECTION: \_\_\_\_\_

Please indicate well location X.

ADDITIONAL INFORMATION

A series of horizontal lines provided for entering additional information.

RECEIVED

If more than one screen, show locations of each on sketch.