

COUNTY WELL LOCATED  
**Jackson**

WELL NUMBER  
**D 2155**

CODED  
**9-1492**

DATE WELL COMPLETED

#1 **0408**

PERMIT NUMBER  
**F-4709/e Well Sec.**

NAME OF DRILLING FIRM  
**128 Box 3**

**Lucedale ms 39452**

MISSISSIPPI DEPARTMENT OF ENVIRONMENTAL QUALITY  
Bureau of Land and Water Resources

P. O. Box 10631  
Jackson, MS 39289-0631  
WATER WELL DRILLERS LOG

NAME & MAILING ADDRESS OF LANDOWNER  
**Jennie Jones**  
**17201 e E Dell Rd**  
**Parouayoula ms 39581**

WELL LOCATION: SEC **34** TOWNSHIP **N 15** RANGE **W 05**

DISTANCE **3** Miles **East** of **Hurley**

OTHER LANDMARK  
**East of Bank of Lucedale**

WELL PURPOSE: Home, Irrigation, Municipal, Industrial, Fish Pond, etc.

PUMP DATA

PUMP TYPE (Circle One):  
Submersible, Turbine, **Jet** Flowing Well, Other (Describe) \_\_\_\_\_

POWER TYPE (Circle One):  
**Electric** Tractor, Diesel, Gasoline, Butane, Other (Describe) \_\_\_\_\_ H/P \_\_\_\_\_

Pump Capacity (GPM) **10** No. of Stages **2** Setting Depth **40'** FT.

PUMP TEST  
Well yielded **10** GPM with a drawdown of **10'** ft. after **1 1/2** hours of pumping

WELL DATA

Well Depth <b>170'</b>	Casing Diameter (In.) <b>2"</b>	Casing Length (Ft.) <b>160'</b>
Type of Casing <b>Pvc</b>	Hole Depth <b>170'</b>	Depth to Static Water Level <b>50'</b>

TYPE OF COMPLETION: (Circle One or More):  
Gravel Packed, Underreamed, Telescoped, Natural Development, Open Hole, Other (Describe) **air lift**

Top of Lap Pipe or Reduction in Casing

FEET IF TELESCOPED OR MORE THAN ONE SCREEN: USE BACK PAGE

LOG DATA

TYPE OF LOG RUN (Circle One):  
No Log Run, Electric, Gamma Ray, Density, Sonic, Neutron, Other (Describe) \_\_\_\_\_

Name of Organization Running Log

SCREEN DATA

Diameter - Inches <b>10'</b>	Length - Feet <b>10'</b>	Slot Size - Inches <b>#6</b>
Screen Type <b>Pvc wrapped</b>	Depth to Bottom - Feet <b>170'</b>	

GEOLOGIC DATA (Office Use Only)

Surface Elev.	Geologic Unit	Unit Thickness	Depth to Top
Subs. SWL	Date	Analysis	Aquifer Test

Driller's Remarks  
**good well**

DESCRIPTION OF FORMATIONS ENCOUNTERED	FROM	TO
<b>top soil</b>	<b>0</b>	<b>5</b>
<b>clay</b>	<b>5</b>	<b>20</b>
<b>Sand</b>	<b>20</b>	<b>30</b>
<b>clay</b>	<b>30</b>	<b>110</b>
<b>clay</b>	<b>110</b>	<b>140</b>
<b>strata of fine clay</b>	<b>140</b>	<b>150</b>
<b>Sand</b>	<b>150</b>	<b>170</b>

FORMATIONS (Continued)

FROM TO

**RECEIVED**


**JAN 27 1993**

Dept. of Environmental Quality  
Office of Land & Water Resources

IF MORE SPACE IS NEEDED, USE BACK

If well telescopes please sketch and show depths.

GROUND LEVEL

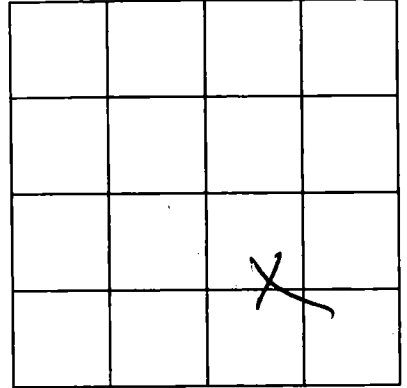

SECTION

~~37~~ 4

Please indicate well location X.

ADDITIONAL INFORMATION

If more than one screen, show location of each on sketch.