

COUNTY WELL LOCATED  
**Jackson**

WELL NUMBER  
**D 267**

CODED

DATE WELL COMPLETED  
**9-14-92**

# **2** MISSISSIPPI DEPARTMENT OF ENVIRONMENTAL QUALITY  
**0-408** Bureau of Land and Water Resources

PERMIT NUMBER  
**Flyfoyle Well Sen**

NAME OF DRILLING FIRM  
**Rt 8 Box 3**

**Succede ms39452**

P. O. Box 10631  
Jackson, MS 39289-0631  
WATER WELL DRILLERS LOG

NAME & MAILING ADDRESS OF LANDOWNER  
**Jennie Jones**  
**17201 CE Hill Rd**  
**Pascagoula, MS 39581**

WELL LOCATION: SEC **34** TOWNSHIP **T4** RANGE **NR5 E**

DISTANCE **3** Miles **East** of **Merley**

OTHER LANDMARK  
**East at Bank of Lumbago Cooper Rd.**

WELL PURPOSE:  Home Irrigation,  Municipal,  Industrial,  Fish Pond, etc.

PUMP DATA

PUMP TYPE (Circle One):  
Submersible, Turbine,  Jet, Flowing Well,  
Other (Describe) \_\_\_\_\_

POWER TYPE (Circle One):  
 Electric,  Tractor,  Diesel,  Gasoline,  Butane,  
Other (Describe) **H/P**

Pump Capacity (GPM) **10** No. of Stages **2** Setting Depth **40'** FT.

PUMP TEST

Well yielded **10** GPM with  
a drawdown of **10'** ft.  
after **1 1/2** hours of pumping

WELL DATA

Well Depth **170'** Casing Diameter (In.) **2"** Casing Length (Ft.) **160'**

Type of Casing **PVC** Hole Depth **170'** Depth to Static Water Level **50'**

TYPE OF COMPLETION: (Circle One or More):  
 Gravel Packed,  Underreamed,  Telescoped,  
 Natural Development,  Open Hole,  Other  
(Describe) **air lift**

Top of Lap Pipe or Reduction in Casing

FEET IF TELESCOPED OR MORE THAN ONE SCREEN: USE BACK PAGE

LOG DATA

TYPE OF LOG RUN (Circle One):  
 No Log Run,  Electric,  Gamma Ray,  Density,  Sonic,  Neutron,  
Other (Describe) \_\_\_\_\_

Name of Organization Running Log

SCREEN DATA

Diameter - Inches **10"** Length - Feet **10'** Slot Size - Inches **# 8**

Screen Type **PVC wrapped** Depth to Bottom - Feet **170'**

GEOLOGIC DATA (Office Use Only)

Surface Elev.	Geologic Unit	Unit Thickness	Depth to Top

Subs. SWL Date Analysis Aquifer Test

Driller's Remarks  
**Ex to Free well**  
**Should be good quality**

DESCRIPTION OF FORMATIONS ENCOUNTERED	FROM	TO	FORMATIONS (Continued)	FROM	TO
<b>Top Soil</b>	<b>0</b>	<b>5</b>			
<b>Clay</b>	<b>5</b>	<b>20</b>			
<b>Sand</b>	<b>20</b>	<b>30</b>			
<b>Clay</b>	<b>30</b>	<b>110</b>			
<b>Clay</b>	<b>110</b>	<b>140</b>			
<b>Struck Shell &amp; Clay</b>	<b>140</b>	<b>158</b>			
<b>Sand</b>	<b>150</b>	<b>170</b>			

**RECEIVED**


**JAN 27 1993**

Dept. of Environmental Quality  
Office of Land & Water Resources

IF MORE SPACE IS NEEDED, USE BACK

If well telescopes please sketch and show depths.

GROUND LEVEL

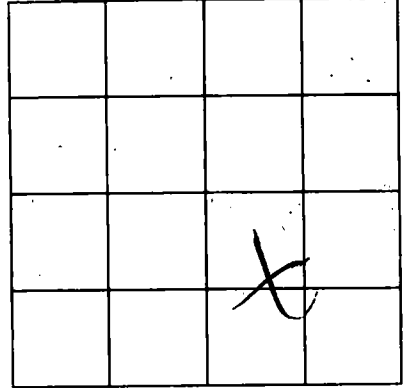

SECTION

~~30~~ 34

Please indicate well location X.

ADDITIONAL INFORMATION

Lined area for additional information.

BRITISH  
SOUTH AFRICA

If more than one screen, show location of each on sketch.