

MISSISSIPPI DEPARTMENT OF ENVIRONMENTAL QUALITY
Bureau of Land and Water Resources

P. O. Box 10631
Jackson, MS 39289-0631
WATER WELL DRILLERS LOG

COUNTY WELL LOCATED <i>Jackson</i>	
WELL NUMBER <i>D2459</i>	CODES
DATE WELL COMPLETED <i>12-31-92</i>	

SOUTHERN WATER WELL SERVICE
NAME OF DRILLING FIRM
Hurley, MS 39555
Post Office Box 185
Phone 588-2756

NAME & MAILING ADDRESS OF LANDOWNER

Olga Rubino
Joe Rubino Rd
Hurley, MS 39555

WELL LOCATION: SEC TOWNSHIP RANGE

33 *4* *5*
(S) *(W)*

DISTANCE DIRECTION NEAREST TOWN

_____ Miles of _____

OTHER LANDMARK

WELL PURPOSE: Home, Irrigation, Municipal, Industrial, Fish Pond, etc.

Home

PUMP DATA

PUMP TYPE (Circle One): Submersible, Turbine, Jet, Other (Describe) _____

POWER TYPE (Circle One): Electric, Tractor, Diesel, Gasoline, Butane, Other (Describe) _____ H/P _____

Pump Capacity (GPM) No. of Stages Setting Depth

12 _____ _____ **FT.**

PUMP TEST

Well yielded *7* GPM with a drawdown of *N/A* ft. after *N/A* hours of pumping

WELL DATA

Well Depth <i>30'</i>	Casing Diameter (In.) <i>2"</i>	Casing Length (Ft.) <i>25'</i>
Type of Casing <i>PVC</i>	Hole Depth <i>30'</i>	Depth to Static Water Level <i>15'</i>

TYPE OF COMPLETION: (Circle One or More): Gravel Packed, Underreamed, Telescoped, Natural Development, Open Hole, Other

(Describe) *air*

Top of Lap Pipe or Reduction in Casing

FEET _____ IF TELESCOPED OR MORE THAN ONE SCREEN: USE BACK PAGE

LOG DATA

TYPE OF LOG RUN (Circle One): No Log Run, Electric, Gamma Ray, Density, Sonic, Neutron, Other (Describe) *N/A*

Name of Organization Running Log _____

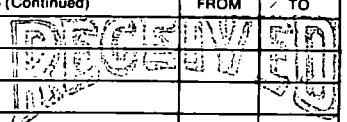
SCREEN DATA

Diameter - Inches <i>2"</i>	Length - Feet <i>5'</i>	Slot Size - Inches <i>#8</i>
Screen Type <i>PVC</i>	Depth to Bottom - Feet <i>30'</i>	

GEOLOGIC DATA (Office Use Only)

Surface Elev.	Geologic Unit	Unit Thickness	Depth to Top
Subs. SWL	Date	Analysis	Aquifer Test
Driller's Remarks			

DESCRIPTION OF FORMATIONS ENCOUNTERED	FROM	TO	FORMATIONS (Continued)	FROM TO	
				FROM	TO
<i>Sand</i>	<i>0</i>	<i>30</i>			


FEB 23 1993
 Dept. of Environmental Quality
 Office of Land & Water Resources

IF MORE SPACE IS NEEDED, USE BACK

If well telescopes please
sketch and show depths.

GROUND LEVEL

SECTION _____

Please indicate well location X.

ADDITIONAL INFORMATION

If more than one screen,
show location of each on sketch.