

MISSISSIPPI DEPARTMENT OF ENVIRONMENTAL QUALITY

Office of Land and Water Resources

P. O. Box 10631

Jackson, MS 39289-0631

WATER WELL DRILLERS LOG

COUNTY WELL LOCATED Jackson	
WELL NUMBER D 2234	CODED
DATE WELL COMPLETED 3-20-99	

PERMIT NUMBER
NAME OF DRILLING FIRM Coast Water Well Service

NAME & MAILING ADDRESS OF LANDOWNER Emmett Royals John Holder Rd. Hurley, Ms			
WELL LOCATION:	SEC 34	TOWNSHIP 4^N	RANGE 5^{EW}
DISTANCE 1 1/2 Miles	DIRECTION EAST	NEAREST TOWN Hurley	
OTHER LANDMARK			
WELL PURPOSE <input checked="" type="radio"/> Home Irrigation, Municipal, Industrial, Fish Pond, etc.			

PUMP DATA		
PUMP TYPE (Circle One): Submersible, Turbine, <input checked="" type="radio"/> Jet Flowing Well, Other (Describe) _____		
POWER TYPE (Circle One): <input checked="" type="radio"/> Electric , Tractor, Diesel, Gasoline, Butane, Other (Describe) _____ H/P _____		
Pump Capacity (GPM) 7.5	No. of Stages 2	Setting Depth FT.
PUMP TEST Well yielded _____ GPM with a drawdown of _____ ft. after _____ hours of pumping		

WELL DATA		
Well Depth 58'	Casing Diameter (In.) 2"	Casing Length (Ft.) 48'
Type of Casing PVC	Hole Depth 58'	Depth to Static Water Level 25'

LOG DATA	
TYPE OF LOG RUN (Circle One): Electric, Gamma Ray, Density, Sonic, Neutron, Other (Describe) _____ <input checked="" type="radio"/> No Log Run	
Name of Organization Running Log	

TYPE OF COMPLETION: (Circle One or More):
 Gravel Packed, Underreamed, Telescoped,
 ~~Natural Development~~, Open Hole, Other
 (Describe) _____

GEOLOGIC DATA (Office Use Only)			
Surface Elev.	Geologic Unit	Unit Thickness	Depth to Top
Subs. SWL	Date	Analysis	Aquifer Test

WELL GROUTED TO A DEPTH OF _____ FEET
 Type Grout (circle one): Cement, Bentonite, or Mix

SCREEN DATA		
Diameter - Inches 2"	Length - Feet 10'	Slot Size - Inches .008
Screen Type PVC	Depth to Bottom - Feet 58'	

Driller's Remarks


DESCRIPTION OF FORMATIONS ENCOUNTERED	FROM	TO
Brown Clay	0	15
White sand	15	58

FORMATIONS (Continued)	FROM	TO
RECEIVED		
APR 12 1999		
Dept. of Environmental Quality Office of Land & Water Resources		

IF MORE SPACE IS NEEDED, USE BACK

If well telescopes please sketch and show depths.

GROUND LEVEL

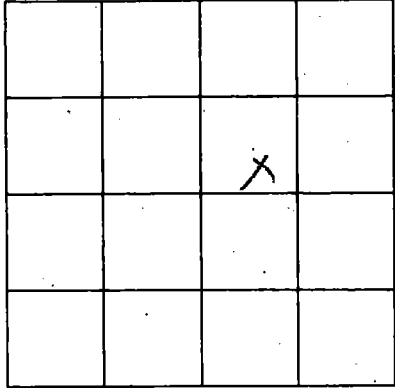

SECTION

34

Please indicate well location X.

ADDITIONAL INFORMATION

If more than one screen,
show location of each on sketch.