

**MISSISSIPPI DEPARTMENT OF ENVIRONMENTAL QUALITY**

Office of Land and Water Resources

P. O. Box 10631  
Jackson, MS 39289-0631  
**WATER WELL DRILLERS LOG**

COUNTY WELL LOCATED <i>Jackson</i>	
WELL NUMBER <i>0-2259</i>	CODED
DATE WELL COMPLETED <i>4-12-00</i>	

PERMIT NUMBER
NAME OF DRILLING FIRM <i>Pruce Well</i>

NAME & MAILING ADDRESS OF LANDOWNER <i>Barney Parker</i>			
<i>Hurley, Ms</i>			
WELL LOCATION	SEC	TOWNSHIP	RANGE
	<i>6</i>	<i>4</i>	<i>5</i>
DISTANCE	DIRECTION	NEAREST TOWN	
<i>1/2</i> Miles	<i>S</i>	<i>George Co</i>	
OTHER LANDMARK			
WELL PURPOSE <input checked="" type="checkbox"/> Home, <input type="checkbox"/> Irrigation, <input type="checkbox"/> Municipal, <input type="checkbox"/> Industrial, <input type="checkbox"/> Fish Pond, etc.			

<b>PUMP DATA</b>		
PUMP TYPE (Circle One): Submersible, Turbine, <input checked="" type="radio"/> Jet, Flowing Well, Other (Describe) _____		
POWER TYPE (Circle One): <input checked="" type="radio"/> Electric, Tractor, Diesel, Gasoline, Butane, Other (Describe) _____ H/P <i>1</i>		
Pump Capacity (GPM) <i>10</i>	No. of Stages <i>2</i>	Setting Depth _____ FT.
PUMP TEST		
Well yielded _____ <i>8</i> GPM with a drawdown of _____ <i>10</i> ft. after _____ <i>1</i> hours of pumping		

<b>WELL DATA</b>		
Well Depth <i>310</i>	Casing Diameter (in.) <i>2"</i>	Casing Length (ft.) <i>300'</i>
Type of Casing <i>Plastic</i>	Hole Depth <i>310'</i>	Depth to Static Water Level <i>50'</i>
TYPE OF COMPLETION: (Circle One or More): <input checked="" type="checkbox"/> Gravel Packed, <input type="checkbox"/> Underreamed, <input type="checkbox"/> Telescoped, <input checked="" type="checkbox"/> Natural Development, <input type="checkbox"/> Open Hole, <input type="checkbox"/> Other (Describe) _____		
WELL GROUTED TO A DEPTH OF <i>15</i> FEET Type Grout (circle one): Cement, Bentonite, or <input checked="" type="checkbox"/> Mix		

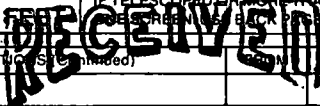
<b>LOG DATA</b>	
TYPE OF LOG RUN (Circle One): Electric, Gamma Ray, Density, Sonic, Neutron, Other (Describe) _____ <input checked="" type="radio"/> No Log Run.	
Name of Organization Running Log	

<b>SCREEN DATA</b>		
Diameter - Inches <i>2 1/2</i>	Length - Feet <i>10</i>	Slot Size - Inches <i>004</i>
Screen Type <i>Plastic</i>	Depth to Bottom - Feet <i>310</i>	

<b>GEOLOGIC DATA (Office Use Only)</b>			
Surface Elev.	Geologic Unit	Unit Thickness	Depth to Top
Subs. SWL	Date	Analysis	Aquifer Test

Driller's Remarks		
Top of Lap Pipe or Reduction in Casing		
IF TELESCOPED OR MORE THAN ONE SCREEN, USE BACK PAGE		

DESCRIPTION OF FORMATIONS ENCOUNTERED	FROM	TO
<i>Top Soil</i>	<i>0</i>	<i>10</i>
<i>Clay</i>	<i>10</i>	<i>280</i>
<i>Good Sand</i>	<i>280</i>	<i>310</i>

 JUN 27 2000 Dept. of Environmental Quality Office of Land & Water Resources	
IF MORE SPACE IS NEEDED, USE BACK	

If well telescopes please  
sketch and show depths.

GROUND LEVEL


SECTION \_\_\_\_\_

Please indicate well location X.

ADDITIONAL INFORMATION

RECEIVED

NOV 5 1960

Office of Environmental Resources  
Department of Environmental Control

If more than one screen,  
show location of each on sketch.