

MISSISSIPPI DEPARTMENT OF ENVIRONMENTAL QUALITY

Office of Land and Water Resources

P. O. Box 10631
Jackson, MS 39289-0631
WATER WELL DRILLERS LOG

COUNTY WELL LOCATED <i>Jackson</i>	
WELL NUMBER <i>D-2269</i>	CODED
DATE WELL COMPLETED <i>8-28-00</i>	

PERMIT NUMBER
NAME OF DRILLING FIRM <i>Pura Well</i>

NAME & MAILING ADDRESS OF LANDOWNER <i>Jo Ann Baker</i>			
<i>Holder Rd.</i>			
<i>Hurley, MS</i>			
WELL LOCATION	SEC	TOWNSHIP	RANGE
	<i>35</i>	<i>4 N</i>	<i>5 E</i>
DISTANCE	DIRECTION	NEAREST TOWN	
<i>1</i> Miles	<i>NE</i>	of <i>Hurley</i>	
OTHER LANDMARK			
WELL PURPOSE: <input checked="" type="checkbox"/> Home, <input type="checkbox"/> Irrigation, <input type="checkbox"/> Municipal, <input type="checkbox"/> Industrial, <input type="checkbox"/> Fish Pond, etc.			

PUMP DATA		
PUMP TYPE (Circle One): Submersible, Turbine, <input checked="" type="radio"/> <i>Jet</i> Flowing Well, Other (Describe) _____		
POWER TYPE (Circle One): <input checked="" type="radio"/> <i>Electric</i> , Tractor, Diesel, Gasoline, Butane, Other (Describe) _____ H/P <i>1</i>		
Pump Capacity (GPM) <i>10</i>	No. of Stages <i>2</i>	Setting Depth <i>60</i> FT.
PUMP TEST		
Well yielded <i>10</i> GPM with a drawdown of <i>10</i> ft. after <i>1</i> hours of pumping		

WELL DATA		
Well Depth <i>195</i>	Casing Diameter (In.) <i>2"</i>	Casing Length (Ft.) <i>185'</i>
Type of Casing <i>Plastic</i>	Hole Depth <i>195'</i>	Depth to Static Water Level <i>50'</i>

LOG DATA	
TYPE OF LOG RUN (Circle One): Electric, Gamma Ray, Density, Sonic, <input checked="" type="radio"/> <i>No Log Run</i> , Other (Describe) _____	
Name of Organization Running Log	

TYPE OF COMPLETION: (Circle One or More):
 Gravel Packed, Underreamed, Telescoped,
 Natural Development, Open Hole, Other
(Describe) _____

GEOLOGIC DATA (Office Use Only)			
Surface Elev.	Geologic Unit	Unit Thickness	Depth to Top
Subs. SWL	Date	Analysis	Aquifer Test

WELL GROUTED TO A DEPTH OF *15 FEET*
Type Grout (circle one): Cement, Bentonite, or *Mix*

SCREEN DATA		
Diameter - Inches <i>2"</i>	Length - Feet <i>10</i>	Slot Size - Inches <i>006</i>
Screen Type <i>Plastic</i>	Depth to Bottom - Feet <i>195'</i>	

Driller's Remarks
RECEIVED
Top of Lap Pipe or Reduction in Casing FEET <i>0</i> <small>IF TELESCOPED MORE THAN ONE SCREEN: USE BACK PAGE</small>

DESCRIPTION OF FORMATIONS ENCOUNTERED	FROM	TO
<i>Top soil</i>	<i>0</i>	<i>10</i>
<i>Clay</i>	<i>10</i>	<i>20</i>
<i>Sand</i>	<i>20</i>	<i>30</i>
<i>Clay</i>	<i>30</i>	<i>170</i>
<i>Gravel Sand</i>	<i>170</i>	<i>195</i>


FORMATIONS (Continued)	FROM	TO

Dept. of Environmental Quality
Office of Land & Water Resources

IF MORE SPACE IS NEEDED, USE BACK

If well telescopes please
sketch and show depths.

GROUND LEVEL

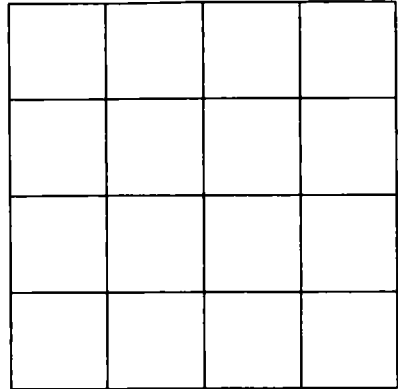

SECTION _____

Please indicate well location X.

ADDITIONAL INFORMATION

If more than one screen,
show location of each on sketch.