

**MISSISSIPPI DEPARTMENT OF ENVIRONMENTAL QUALITY**  
Office of Land and Water Resources

P. O. Box 10631  
Jackson, MS 39289-0631  
**WATER WELL DRILLERS LOG**

COUNTY WHERE WELL IS LOCATED  
**Jackson**

WELL NUMBER  
**D-2277**

CODED

DATE WELL COMPLETED  
**11-2-00**

PERMIT NUMBER

NAME OF DRILLING FIRM  
**Coast Water Well Service**

NAME & MAILING ADDRESS OF LANDOWNER  
**Ollie Mae Dees**  
**Wesley Powell Rd.**  
**Hurley Ms**

WELL LOCATION    SEC    TOWNSHIP    RANGE  
**7    4    5**

DISTANCE    DIRECTION    NEAREST TOWN  
**4** Miles **NW** of **Hurley**

OTHER LANDMARK

WELL PURPOSE  Home,  Irrigation,  Municipal,  Industrial,  Fish Pond, etc.

**PUMP DATA**

PUMP TYPE (Circle One):  
Submersible, Turbine,  Jet, Flowing Well,  
Other (Describe) \_\_\_\_\_

POWER TYPE (Circle One):  
 Electric, Tractor, Diesel, Gasoline,  Butane,  
Other (Describe) \_\_\_\_\_ H/P **1**

Pump Capacity (GPM)    No. of Stages    Setting Depth  
**7.5**    **2**    \_\_\_\_\_ FT.

PUMP TEST

Well yielded \_\_\_\_\_ GPM with  
a drawdown of \_\_\_\_\_ ft.  
after \_\_\_\_\_ hours of pumping

**WELL DATA**

Well Depth <b>303'</b>	Casing Diameter (In.) <b>2"</b>	Casing Length (Ft.) <b>293'</b>
Type of Casing <b>PVC</b>	Hole Depth <b>303'</b>	Depth to Static Water Level <b>60'</b>

**LOG DATA**

TYPE OF LOG RUN (Circle One):  
Electric, Gamma Ray, Density, Sonic, Neutron,  
Other (Describe) \_\_\_\_\_  No Log Run

Name of Organization Running Log

TYPE OF COMPLETION: (Circle One or More):  
 Gravel Packed,  Underreamed,  Telescoped,  
 Natural Development,  Open Hole,  Other

WELL GROUTED TO A DEPTH OF **20** FEET  
Type Grout (circle one):  Cement,  Bentonite, or Mix

**GEOLOGIC DATA (Office Use Only)**

Surface Elev.	Geologic Unit	Unit Thickness	Depth to Top
Subs. SWL	Date	Analysis	Aquifer Test

Driller's Remarks

Top of Log Pipe (to \_\_\_\_\_ ft. from casing)  
**IF TELESCOPED OR MORE THAN ONE SCREEN: USE BACK PAGE**

**SCREEN DATA**

Diameter - Inches <b>2"</b>	Length - Feet <b>10'</b>	Slot Size - Inches <b>.008</b>
Screen Type <b>PVC</b>	Depth to Bottom - Feet <b>303'</b>	

DESCRIPTION OF FORMATIONS ENCOUNTERED	FROM	TO
Top Soil	0	2
Brown clay	2	10
White coarse sand	10	45
Blue clay	45	80
Medium Gray Sand	80	95
Blue clay	95	265
Medium Gray Sand	265	282
Gray coarse Sand	282	303

FORMATIONS Continued

**JAN 17 2001**


Dept. of Environmental Quality  
Office of Land & Water Resources

FROM	TO

IF MORE SPACE IS NEEDED USE BACK

If well telescopes please sketch and show depths.

GROUND LEVEL

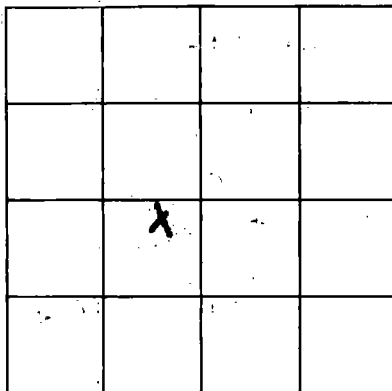

SECTION 7

Please indicate well location X.

ADDITIONAL INFORMATION

RECEIVED  
NOV 19 1966  
DIVISION OF WATER RESOURCES  
STATE OF CALIFORNIA

If more than one screen, show location of each on sketch.