

MISSISSIPPI DEPARTMENT OF ENVIRONMENTAL QUALITY

Office of Land and Water Resources

P. O. Box 10631
Jackson, MS 39289-0631

WATER WELL DRILLERS LOG

COUNTY WELL LOCATED
Jackson

WELL NUMBER CODED
D-2294

DATE WELL COMPLETED
5-25-01

0408

PERMIT NUMBER
Frutiger Well Ser.

NAME OF DRILLING FIRM
194 Depot Rd

Rosedale MS 39452

NAME & MAILING ADDRESS OF LANDOWNER
Pete Bonfigliolo
1281-Tanner Williams Rd
Harleston MS

WELL LOCATION SECTION TOWNSHIP RANGE
Tanner Williams A TH N R5 E W

DISTANCE DIRECTION NEAREST TOWN
1 1/2 Miles East of Emerson Store

OTHER LANDMARK
off 63 to ON Tanner Williams

WELL PURPOSE: Home Irrigation, Municipal, Industrial, Fish Pond, etc.

PUMP DATA

PUMP TYPE (Circle One):
Submersible, Turbine, Jet, Flowing Well,
Other (Describe) _____

*POWER TYPE (Circle One):
 Electric, Tractor, Diesel, Gasoline, Butane,
Other (Describe) _____ H/P 1

Pump Capacity (GPM) No. of Stages Setting Depth
10 2 35' FT.

PUMP TEST

Well yielded 10 GPM with
a drawdown of 5 ft.
after 1 1/2 hours of pumping

WELL DATA

Well Depth <u>50</u>	Casing Diameter (In.) <u>2"</u>	Casing Length (Ft.) <u>10'</u>
Type of Casing <u>PVC</u>	Hole Depth <u>50</u>	Depth to Static Water Level <u>30'</u>

TYPE OF COMPLETION: (Circle One or More):
 Gravel Packed, Underreamed, Telescoped,
 Natural Development, Open Hole, Other
(Describe) air lift

WELL GROUTED TO A DEPTH OF 20 FEET
Type Grout (circle one): Cement, Bentonite, or Mix

LOG DATA

TYPE OF LOG RUN (Circle One):
 No Log Run, Electric, Gamma Ray, Density, Sonic, Neutron,
Other (Describe) _____

Name of Organization Running Log _____

SCREEN DATA

Diameter - Inches <u>2"</u>	Length - Feet <u>10'</u>	Slot Size - Inches <u>#8</u>
Screen Type <u>Samed Screen</u>	Depth to Bottom - Feet <u>50</u>	

GEOLOGIC DATA (Office Use Only)

Surface Elev.	Geologic Unit	Unit Thickness	Depth to Top
Subs. SWL	Date	Analysis	Aquifer Test

Driller's Remarks _____

Top of Lap Pipe or Reduction in Casing _____

FEET IF TELESCOPED OR MORE THAN ONE SCREEN: USE BACK PAGE

DESCRIPTION OF FORMATIONS ENCOUNTERED	FROM	TO
<u>Top Soil</u>	<u>0</u>	<u>5</u>
<u>Clay</u>	<u>5</u>	<u>20</u>
<u>Soft Clay</u>	<u>20</u>	<u>40</u>
<u>Soft</u>	<u>40</u>	<u>50</u>


FORMATIONS (Continued)	FROM	TO

REC'D JUN 25 2001

IF MORE SPACE IS NEEDED, USE BACK

If well telescopes please
sketch and show depths.

GROUND LEVEL

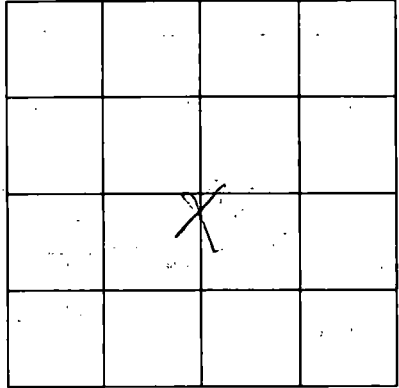

SECTION 4

Please indicate well location X.

ADDITIONAL INFORMATION

If more than one screen,
show location of each on sketch.