

D-2317

MISSISSIPPI DEPARTMENT OF ENVIRONMENTAL QUALITY

Office of Land and Water Resources

P. O. Box 10631
Jackson, MS 39289-0631
WATER WELL DRILLERS LOG

COUNTY WELL LOCATED	
Jackson	
WELL NUMBER	CODED
02022	
N/A	
DATE WELL COMPLETED	
6-17-02	

PERMIT NUMBER
NAME OF DRILLING FIRM
Harvard Drilling Co.

NAME & MAILING ADDRESS OF LANDOWNER
Jeannette Bryant
7900 Belle Etheridge Rd
Lucedale MS 39452
Latitude: 30° 41. 236 N
Longitude: 88° 28. 673 W
WELL LOCATION. SEC TOWNSHIP RANGE
22 T 4 N R 5 E
DISTANCE DIRECTION NEAREST TOWN
1.5 Miles N-E of Hurley
OTHER LANDMARK
Escatawpa River
WELL PURPOSE: Home, Irrigation, Municipal, Industrial, Fish Pond, etc.
Home

PUMP DATA		
PUMP TYPE (Circle One):		
Submersible, Turbine, Other (Describe)		<input checked="" type="radio"/> Flowing Well.
POWER TYPE (Circle One):		
<input checked="" type="radio"/> Electric Tractor, Diesel, Gasoline, Butane, Other (Describe)	N/A	H/P 1
DESCRIPTION OF FORMATIONS ENCOUNTERED	FROM	TO
Topsand	0	6
Sand, Very Fine	6	25
Clay	25	37
Sand, Fine to med	37	50
Sand, med	50	75
Sand, Fine to med	75	77
RECEIVED		
JUL 03 2002		
BY: OLWR		
Top of Lap Pipe or Reduction in Casing		
FEET	IF TELESCOPED OR MORE THAN ONE SCREEN: USE BACK PAGE	

WELL DATA		
Well Depth	Casing Diameter (In.)	Casing Length (Ft.)
75'	2"	65'
Type of Casing	Hole Depth	Depth to Static Water Level
PVC 540	77'	28'
TYPE OF COMPLETION: (Circle One or More):		
<input checked="" type="checkbox"/> Gravel Packed, Natural Development, (Describe) N/A	<input type="checkbox"/> Underreamed, Open Hole.	<input type="checkbox"/> Telescoped, Other
WELL GROUTED TO A DEPTH OF 13 FEET		
Type Grout (circle one): Cement, Bentonite, or <input checked="" type="checkbox"/> Mix		

SCREEN DATA		
Diameter - Inches	Length - Feet	Slot Size - Inches
2"	10'	.008
Screen Type	Depth to Bottom - Feet	
PVC WOP 540	75'	

I certify that the well was drilled, constructed and completed in accordance with all applicable Requirements of the Mississippi Department of Environmental Quality and/or the Mississippi Department of Health regulations and state laws.


Michael Hand 0-673
Signature of Licensed Driller and License No.

6-17-02
Date

Additional Information Required On Back

If well telescopes please sketch and show depths.

GROUND LEVEL

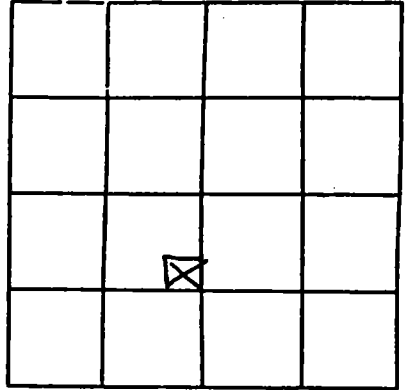

SECTION 22

Please indicate well location X.

Pump Capacity (GPM)	No. of Stages	Setting Depth
9	2	60 FT.

PUMP TEST

Well yielded 9 GPM with
a drawdown of 12 ft.
after 1 hours of pumping

LOG DATA

TYPE OF LOG RUN (Circle One): No Log Run
Electric, Gamma Ray, Density, Sonic, Neutron,
Other (Describe) _____

Name of Organization Running Log

N/A

GEOLOGIC DATA (Office Use Only)

Surface Elev.	Geologic Unit	Unit Thickness	Depth to Top
Subs. SWL	Date	Analysis	Aquifer Test

Driller's Remarks

If more than one screen,
show location of each on sketch.