

JACKSON MISSISSIPPI BOARD OF WATER CO

E 24
4-5-62

WATER WELL DRILLERS LOG

Date: Apr. 5, 1962, Driller: M & B Drilling Co., County Jackson
55 (Name)


(1) Owner of Land:	Description & Color of Materials Sand, Clay, Red Clay, Shell, etc.	Thick- ness Feet	Depth Feet
(Name) <u>August Parker</u> <u>200 W. Bay View Biloxi Mo.</u> (Address)	<u>Clay</u>	<u>10</u>	<u>10</u>
(2) Location: <u>NE 1/4, WF 1/4, Sec 25 5589</u>	<u>White Sand</u>	<u>4</u>	<u>14</u>
<u>1/8</u> miles <u>N.E.</u> of <u>Biloxi</u> (distance) (direction) (Nearest Town)	<u>Mixed Clay</u>	<u>14</u>	<u>28</u>
(3) Topography: <u>Hilly</u> (Hilly) (Flat) (Level)	<u>Blue Clay</u>	<u>30</u>	<u>58</u>
(4) Purpose of Well: <u>Domestic</u> (Domestic Irrigation Municipal, Industrial, Other)	<u>Sand</u>	<u>7</u>	<u>65</u>
	<u>Blue Clay</u>	<u>90</u>	<u>155</u>
	<u>Sand + Clay Breaks</u>	<u>20</u>	<u>175</u>
	<u>Blue Clay</u>	<u>130</u>	<u>305</u>
	<u>Coarse Grey Sand</u>	<u>62</u>	<u>367</u>

Still cutting sand when stopped drilling

Information upon completion of well:

- (1) Diameter 2 inches.
- (2) Total Depth 367 feet.
- (3) Water Level 45 feet below top of ground.
- (4) Cased to 357, Size 2"
- (5) Screen: Size 2" 8s/10T, Length 10 Ft.
- (6) Were any formations sealed against pollution?
_____ yes, _____ no.

If YES depth of formation _____
Why _____
Drillers Remarks: _____

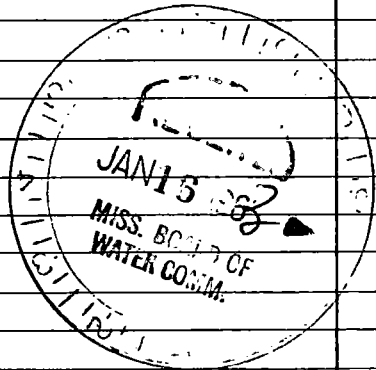

(Use Back Side)

Well No.

Handwritten notes, possibly bleed-through from the reverse side of the page. The text is mostly illegible due to the high contrast and blurriness of the scan. Some words like "Don't" and "Don't" are faintly visible.

Handwritten numbers and symbols, possibly a list or a set of instructions. The text is very faint and difficult to decipher.

Handwritten text at the bottom of the page, possibly a signature or a date. The text is illegible.