

JACKSON MISSISSIPPI BOARD OF WATER COMMISSIONERS

E 26
7-31-63

WATER WELL DRILLERS LOG

Date: July 31, 1963 Driller: L. L. Garland Jackson County: Jackson

55

(1) Owner of Land: Waites
(Name)
La Rue Road
(Address)

(2) Location: 1/4, 1/4, Sec. 27 T.5. R.9 W
3 miles North Patmer
(distance) (direction) (Nearest Town)

(3) Topography: (Hilly) (Flat) (Level)

(4) Purpose of Well: Dom.
(Domestic Irrigation
Municipal, Industrial, Other)

	Description & Color of Materials Sand, Clay, Red Clay, Shell, etc.	Thick- ness Feet	Depth Feet
1	Clay		
2	"		
3	Mud		
4	Mix.		
5	16' Sand, 5' Mud		
6	Mud		
7	Mix.		
8	"		
9	Mud		
10	"		
11	Mix.		
12	"		
13	"		
14	"		
15	"		
16	"		
17	"		
18	"		
19	Sand		
20	16' Sand		

Information upon completion of well:

(1) Diameter 2 inches.

(2) Total Depth 414 feet.

(3) Water Level 20 feet below top of ground.

(4) Cased to _____, Size _____.


(5) Screen: Size .08, Length 10.

(6) Were any formations sealed against pollution?
_____ yes, _____ no.

If YES depth of formation _____

Why _____

Drillers Remarks: _____

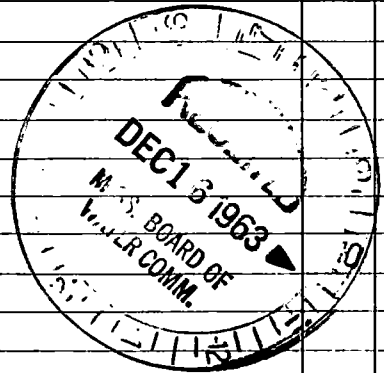

(Use Back Side)

Well No.

Handwritten text at the top of the page, possibly a title or header, which is mostly illegible due to the quality of the scan.

Main body of handwritten text, appearing to be a list or a series of entries. The text is very faint and difficult to decipher.

Bottom section of handwritten text, possibly a conclusion or a signature block. The text is also illegible.