

Jackson
 E 27
 11-67

MISSISSIPPI
 BOARD OF WATER COMMISSIONERS
 416 North State Street
 Jackson, Mississippi 39201

WATER WELL DRILLERS LOG

11-7-67 date well completed
 COAST WATER WELL SERVICE firm name
 JACKSON county well located

LANDOWNER: B. L. PIERCE
 VANDLERE, MISS.

(mailing address)

WELL LOCATION:
 sec. 24 T. 5 N. R. 8 E
 5 miles NE of Vandlere
 (distance) (direction) (nearest town)

WELL PURPOSE: Home
 (home, irrigation, municipal, industrial)


WELL COMPLETION DATA:

- (1) diameter (inches) 2"
- (2) total depth (feet) 107
- (3) static water level (feet) 35' below top of ground.
- (4) casing 2" GALV. 102'
 (material) (depth)
 (size) if telescope see back.
- (5) screen 5' 102'
 (length) (depth to top)
 2" PLASTIC
 (size) (material)
- (6) pump 1 8
 (HP) (yield gpm)
 Elect
 (type power)
- (7) electric log NO
 (yes or no)
 (organization running log)

(8) how well bottom plugged 2" BACK
 WASH W/CLAY

description of formations encountered	from	to
RED CLAY	0	8
COARSE SAND	8	14
BLUE CLAY	14	56
MEDI SAND	56	107


DRILLERS REMARKS:

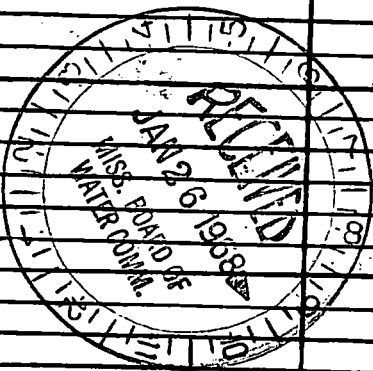

If well telescopes please sketch and show depths.

N W S E

GROUND LEVEL

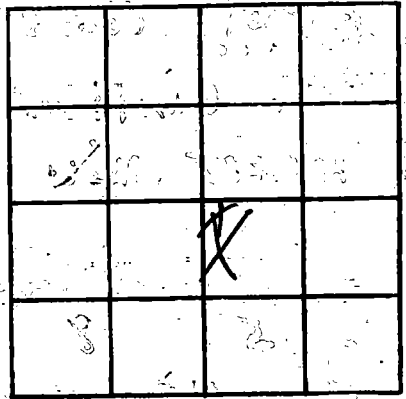

SECTION 24

Please indicate well location X.

ADDITIONAL INFORMATION

If more than one screen, show locations of each on sketch.