

Jackson
E29
5-66

WATER WELL DRILLERS LOG

Date: May 5, 1966, Driller: Joe Miller County Jackson
69 (Name)

(1) Owner of Land: Mr. Cates
(Name)
Yavelous Miss.
(Address)

(2) Location: 1/4, 1/4, Sec. 1 TSRW
7 miles North, of Osborne
(distance) (direction) (Nearest Town)

(3) Topography: Hilly
(Hilly) (Flat) (Level)

(4) Purpose of Well: Domestic
(Domestic Irrigation
Municipal, Industrial, Other)

Description & Color of Materials Sand, Clay, Red Clay, Shell, etc.	Thick- ness Feet	Depth Feet
Brown Clay	30	30
Red Sand	10	40
Red Clay, Hard Clay, Wh.	23	63
Fine Sand, Fine	27	90
White Clay	18	108
Blue Clay	77	175
Sh. Br.	15	190
Hard Blue Clay	14	204
Rock (8")	1	205
Hard Blue Clay, Ruff	150	355
Rock (4")	1	356
Soft Fine Sand	6	362
Hard Blue Clay	113	475
Grey Sand Fine	10	485
" " "	10	495
" " Sand	11	506
" " "	11	517
" " "	3	520
Well Sand		

Information upon completion of well:

(1) Diameter 2" inches.

(2) Total Depth 520' feet.

(3) Water Level 100' feet below top of ground.

(4) Cased to 505, Size 2"


(5) Screen: Size 2", Length 10'

(6) Were any formations sealed against pollution?
_____ yes, _____ no.

If YES depth of formation _____


Why _____

Drillers Remarks: _____

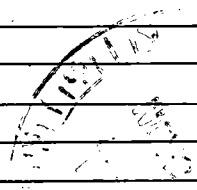

(Use Back Side)

Well No.

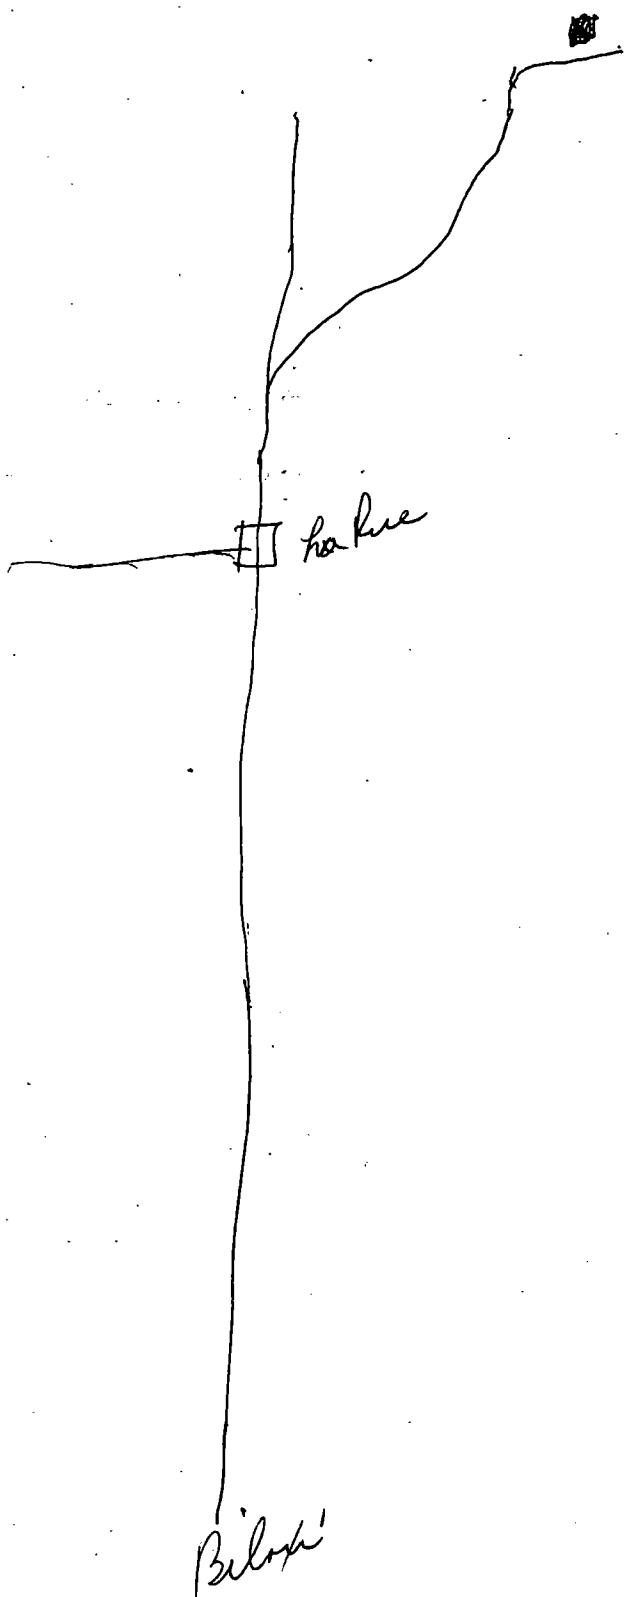

□ Lake

Biloxi