

**MISSISSIPPI  
BOARD OF WATER COMMISSIONERS  
416 North State Street  
Jackson, Mississippi 39201**

**WATER WELL DRILLERS LOG**

JACKSON  
E 30  
5-68

5-7 1968 Coast Water Well Dr. Jackson  
date well completed firm name county well located

LANDOWNER: Chas Keith  
Route 1 Box 286  
Oreng Springs Miss  
(mailing address)

description of formations encountered	from	to
Red Clay thin sand	0	84
Blue clay	84	294
fine sand	294	315
Blue Clay	315	422
Sand med. coarse	422	514

WELL LOCATION:  
sec. 4 T. 5 N. R. 8 E. S. 1 W.  
10 miles NW of Charlottesville  
(distance) (direction) (nearest town)

WELL PURPOSE: Home  
(home, irrigation, municipal, industrial)

- WELL COMPLETION DATA:
- (1) diameter (inches) 2"
  - (2) total depth (feet) 514
  - (3) static water level (feet) 77 <sup>(below)</sup> <sub>above</sub> top of ground.
  - (4) casing galv. 504'  
(material) (depth)  
2"  
(size) If telescope see back.
  - (5) screen 10' 504'  
(length) (depth to top)  
2" stainless  
(size) (material)
  - (6) pump 1 1/2 10  
(HP) (yield gpm)  
Elect  
(type power)
  - (7) electric log NO  
(yes or no)

(organization running log)  
(8) how well bottom plugged Back  
west valve


DRILLERS REMARKS:

MAY 17 1968

MISS. BD. OF  
WATER COMM.

If well telescopes please sketch and show depths.

GROUND LEVEL

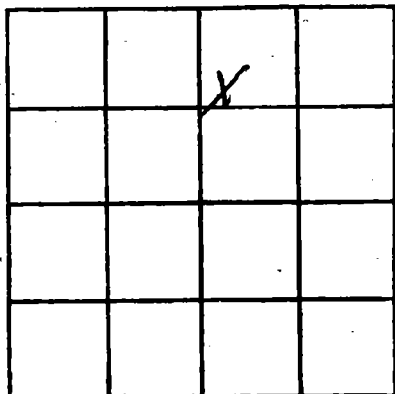

SECTION \_\_\_\_\_

Please indicate well location X.

ADDITIONAL INFORMATION


If more than one screen, show locations of each on sketch.