

Three miles off  
Biloxi Rd on  
O'Neal Rd.

CODED

Jackson  
E 32  
10-2-68

MISSISSIPPI  
BOARD OF WATER COMMISSIONERS  
416 North State Street  
Jackson, Mississippi 39201

WATER WELL DRILLERS LOG

Jackson  
Harrison  
county well located

10-2 1968 date well completed  
Switzer Well Co. firm name  
Harrison county well located

LANDOWNER: T.H. O'Neal

O'Neal Road  
Biloxi Truss  
(mailing address)

WELL LOCATION:  
sec. 4 T 5 S R 8 E W  
6 miles S of VESTAL  
(distance) (direction) (nearest town)

WELL PURPOSE: Home  
(home, irrigation, municipal, industrial)

WELL COMPLETION DATA:

- (1) diameter (inches) 2
- (2) total depth (feet) 531
- (3) static water level (feet) 80 below top of ground.
- (4) casing gal steel 523' (material) (depth)  
2" (size) if telescope see back.
- (5) screen 8' (length), 523' (depth to top)  
10 ga. 55 or pipe (size) (material)
- (6) pump 1/2 (HP), 8.5 GPM (yield gpm)  
electric (type power)
- (7) electric log No (yes or no)

(organization running log)

(8) how well bottom plugged back pressure valve

DRILLERS REMARKS:


description of formations encountered	from	to
clay	0	10
fine sand	10	22
mixed	22	43
clay	43	63
mixed	63	82
fine sand	82	103
mixed	103	123
clay	123	131
sand	131	139
clay	139	143
mixed	143	164
clay	164	185
fine sand	185	226
mixed	226	247
clay	247	259
sand	259	267
mixed	267	331
fine sand	331	373
mixed	373	392
clay	392	425
sand	425	436
clay	436	450
sand	450	451
mixed	451	471
clay	471	477
good sand	477	531

NOV 12 1968

MISS. BD. OF  
WATER COMMISSIONERS

If well telescopes please sketch and show depths.

GROUND LEVEL

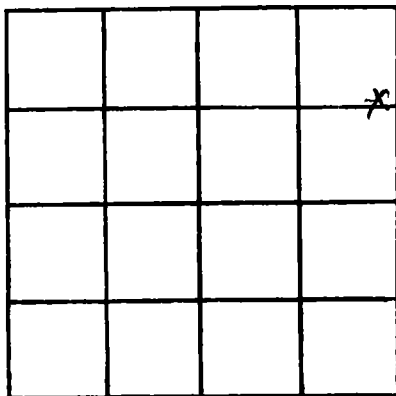

SECTION 4

Please indicate well location X.

ADDITIONAL INFORMATION

Lined area for additional information.

If more than one screen, show locations of each on sketch.