

Jackson  
E 34  
11-13-69

MISSISSIPPI  
BOARD OF WATER COMMISSIONERS  
416 North State Street  
Jackson, Mississippi 39201

CODED  
CODED

WATER WELL DRILLERS LOG

11/13/69 date well completed  
19 Coastal Drilling firm name  
Jackson county well located

LANDOWNER: J.W. Seal

RT1  
Clear Spring Miss  
(mailing address)

WELL LOCATION:  
sec 26 T 5 S R 9 E  
3 miles N Station W  
(distance) (direction) (nearest town)

WELL PURPOSE: home  
(home, irrigation, municipal, industrial)

WELL COMPLETION DATA:

- (1) diameter (inches) 2"
- (2) total depth (feet) 525
- (3) static water level (feet) 16 below top of ground.
- (4) casing 2" 525  
(material) (depth)  
(size) If telescope see back.
- (5) screen 16 509  
(length) (depth to top)  
2" 55  
(size) (material)
- (6) pump 1 HP 21  
(HP) (yield gpm)  
Eli  
(type power)
- (7) electric log No  
(yes or no)

(organization running log) BRH

(8) how well bottom plugged good

DRILLERS REMARKS: none


description of formations encountered	from	to
Top Soil	1	5
Red Clay	5	20
glaze	20	37
White Sand	37	50
Sugar Sand	50	25
Blue Clay	25	400
fine water Sand	400	415
Blue Clay	415	436
Rock + Shell	436	450
fine water Sand	450	475
Coarse water Sand	475	525

JAN 12 1970

MISS ED  
WATER

If well telescopes please sketch and show depths.

GROUND LEVEL

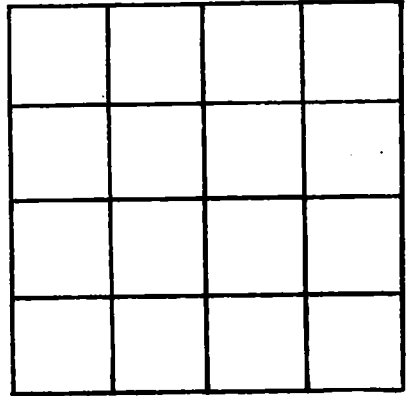

SECTION \_\_\_\_\_

Please indicate well location X.

ADDITIONAL INFORMATION

If more than one screen, show locations of each on sketch.