

Jackson
E 35
11-20-69

MISSISSIPPI
BOARD OF WATER COMMISSIONERS
416 North State Street
Jackson, Mississippi 39201

CODED

WATER WELL DRILLERS LOG

CODED

11/20/69 date well completed
1969 Coastal Drilling firm name
Jackson county well located

LANDOWNER: C.K. Kimmers
Rt 3 Box 267
B Noxi, Miss
(mailing address)

WELL LOCATION:
sec. 35 E. R. 9 S
One miles N of Latonia
(distance) (direction) (nearest town)

WELL PURPOSE: home
(home, irrigation, municipal, industrial)

WELL COMPLETION DATA:

(1) diameter (inches) 2"

(2) total depth (feet) 462

(3) static water level (feet) 36 below top of ground.

(4) casing glass 462
(material) (depth)

(size) If telescope see back.

(5) screen 10' 452
(length) (depth to top)

2" SS
(size) (material)

(6) pump 1 1/2 HP 21
(HP) (yield gpm)

Ele
(type power)

(7) electric log NO
(yes or no)

(organization running log)

(8) how well bottom plugged BM good

description of formations encountered	from	to
Top Soil	1	15
white sand	15	23
Red Clay	23	40
white sand	40	65
Blue clay	65	340
hard blue clay	340	360
Blue clay	360	400
fine water sand	400	425
Coarse water sand	425	462


DRILLERS REMARKS:
None

JAN 12 1971

MISS. BD. OF
WATER COM.

If well telescopes please sketch and show depths.

GROUND LEVEL

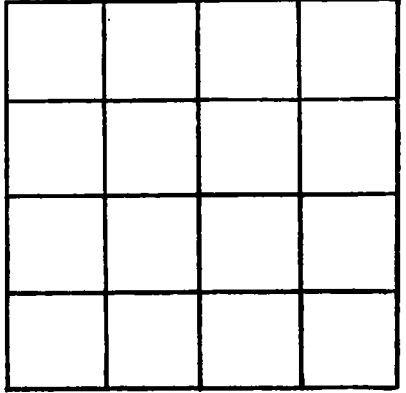

SECTION _____

Please indicate well location X.

ADDITIONAL INFORMATION

If more than one screen, show locations of each on sketch.