

JACKSON
E 36
1-26-70

MISSISSIPPI
BOARD OF WATER COMMISSIONERS
416 North State Street
Jackson, Mississippi 39201

CODED

WATER WELL DRILLERS LOG

1/26 1970 Coastal Well Drilling Jackson
date well completed firm name county well located

LANDOWNER: <i>Ch. Montague</i>	description of formations encountered	from	to
<i>Rt 1</i>	<i>Red Clay</i>	<i>1</i>	<i>15</i>
<i>Clear Spring Miss</i> (mailing address)	<i>white sand</i>	<i>15</i>	<i>36</i>
	<i>glau</i>	<i>36</i>	<i>40</i>
	<i>Red Clay</i>	<i>40</i>	<i>65</i>
	<i>white sand</i>	<i>65</i>	<i>120</i>
	<i>large glau</i>	<i>120</i>	<i>132</i>
	<i>Baked Clay</i>	<i>132</i>	<i>220</i>
	<i>fine water sand</i>	<i>220</i>	<i>233</i>
	<i>coarse water sand</i>	<i>233</i>	<i>260</i>

WELL LOCATION:
sec. *24* T. *5* N. R. *9* E
S. W.
3 1/2 miles *N* *Tator*
(distance) (direction) (nearest town)

WELL PURPOSE: *home*
(home, irrigation, municipal, industrial)

WELL COMPLETION DATA:

(1) diameter (inches) *2"*

(2) total depth (feet) *260*

(3) static water level (feet) *37* below top of ground.

(4) casing *glau*, *2.50*
(material) (depth)

(size) if telescope see back.

(5) screen *10'*, *2.50*
(length) (depth to top)

2", *35*
(size) (material)

(6) pump _____ (HP) _____ (yield gpm)

(type power)

(7) electric log *no*
(yes or no)

(organization running log)

CODED

FEB 5 - 1970


(8) how well bottom plugged
2" backwash valve

DRILLERS REMARKS:
none

MISS. BD. OF
WATER COMM.

If well telescopes please sketch and show depths.

GROUND LEVEL

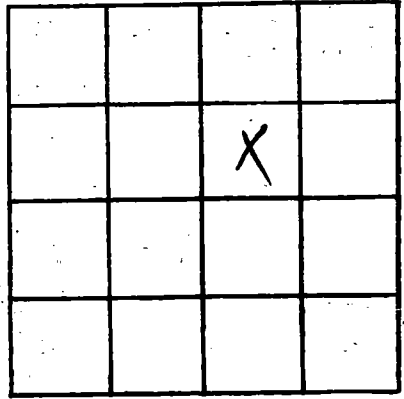

SECTION _____

Please indicate well location X.

ADDITIONAL INFORMATION

If more than one screen, show locations of each on sketch.