

JACKSON MISSISSIPPI BOARD OF WATER COMMISSIONERS

~~E~~ 37

5-25-62

4028

WATER WELL DRILLERS LOG

CODED

Date: 5-25, 1962, Driller: C. T. SWITZER WELL CO. County: Jackson

(Name)

(1) Owner of Land: O. C. Nyein
(Name)

Ol. Home Community
Acorn Springs
(Address)

(2) Location: 1/4, 1/4, Sec. 3 T5 R9
(distance) (direction) (Nearest Town)

(3) Topography: (Hilly) (Flat) (Level)

(4) Purpose of Well: Domestic
(Domestic Irrigation Municipal, Industrial, Other)

Description & Color of Materials Sand, Clay, Red Clay, Shell, etc.	Thick- ness Feet	Depth Feet
<u>Clay</u>	<u>00</u>	<u>20</u>
<u>Sand, red</u>	<u>20</u>	<u>71</u>
<u>Clay</u>	<u>71</u>	<u>97</u>
<u>Sand</u>	<u>97</u>	<u>111</u>
<u>Clay</u>	<u>111</u>	<u>124</u>
<u>Sand, good</u>	<u>124</u>	<u>176</u>

Information upon completion of well:

(1) Diameter 2 inches.

(2) Total Depth 176 feet.

(3) Water Level 28' feet below top of ground.

(4) Cased to 176', Size 2"

(5) Screen: Size 2", Length 10'


(6) Were any formations sealed against pollution?
 yes, no.

If YES depth of formation _____

Why Health Dept. Requirement

Drillers Remarks: _____

CODED

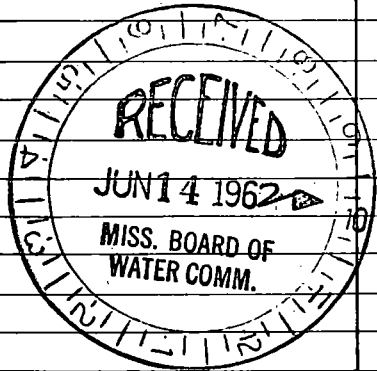

(Use Back Side)

Well No. _____

Retain this copy for your office files.

1880

Small

10
11
12
13
14
15
16

Small
Large
Medium
Small
Large
Medium

Small
Large
Medium

Small
Large
Medium

10

Small
Large
Medium
Small
Large
Medium

Small
Large
Medium
Small
Large
Medium