

JACKSON
E 40
4-14-71

MISSISSIPPI
BOARD OF WATER COMMISSIONERS
416 North State Street
Jackson, Mississippi 39201

CODED

WATER WELL DRILLERS LOG

4/14/71 date well completed
Coastal Drilling Co. firm name
Jackson county well located

LANDOWNER: Jerry Sims

Kt 1 Box 331

O'Clan Spring (mailing address)

WELL LOCATION:

sec. 34 T. 5 N. R. 9 E. S. 1 W.
3 miles NW Lumbia (distance) (direction) (nearest town)

WELL PURPOSE: home (home, irrigation, municipal, industrial)

WELL COMPLETION DATA:

- (1) diameter (inches) 2"
- (2) total depth (feet) 511
- (3) static water level (feet) 12 below top of ground
- (4) casing glass 501 (material) (depth)
- (5) screen 10' 501 (length) (depth to top)
- 2 ft (size) SS (material)
- (6) pump One 18 (HP) (yield gpm)
- Ele (type power)
- (7) electric log no (yes or no)

(organization running log)

(8) how well bottom plugged 2" back wash drilled

DRILLERS REMARKS: none

description of formations encountered	from	to
Top Soil	1	3
Red Clay	3	10
white sand	12	35
Sandy sand	35	60
hd. blue clay	60	190
lgy. hd. blue clay	190	400
fine water sand	400	465
coarse water sand	465	511


CODED

MAY 18 1971

MISS. BD. OF
WATER COMMISSIONERS

If well telescopes please sketch and show depths.

GROUND LEVEL

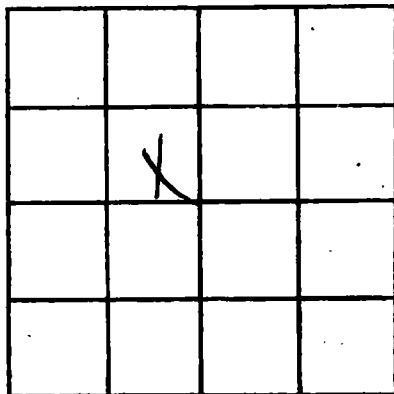

SECTION 34

Please indicate well location X.

ADDITIONAL INFORMATION

If more than one screen,
show locations of each on sketch.