

JACKSON

E 41

4-14-71

MISSISSIPPI BOARD OF WATER COMMISSIONERS
416 North State Street
Jackson, Mississippi 39201

CODED

WATER WELL DRILLERS LOG

4/14/71
date well completed

Coastal Drilling Co.
firm name

Jackson
county well located

LANDOWNER: J.W. Cook

description of formations encountered

from to

Rt 1 Box 315C
Ocean Springs, Miss
(mailing address)

Top Soil	1	5
White Sand	5	25
Gravel	25	30
Green Sand	30	38
Red Blue Sand	38	90
Coarse Water Sand	90	133

WELL LOCATION:

sec. 11 T 5 N R 9 E
S W
6 miles NW Latimer
(distance) (direction) (nearest town)

WELL PURPOSE: home
(home, irrigation, municipal, industrial)

WELL COMPLETION DATA:

- (1) diameter (inches) 2"
- (2) total depth (feet) 133
- (3) static water level (feet) 30 below top of ground
- (4) casing Galv. 123 (material) (depth)
(size) If telescope see back.
- (5) screen 10' 123 (length) (depth to top)
2" 35 (size) (material)
- (6) pump 1/4 HP 16 (HP) (yield gpm)
Elec (type power)
- (7) electric log no (yes or no)
(organization running log)

CODED

(8) how well bottom plugged
2" bank wash debris

DRILLERS REMARKS:

None


MAY 19 1971

MISS. BD. OF WATER COMM.

If well telescopes please sketch and show depths.

GROUND LEVEL

Large vertical rectangular area for sketching well details.

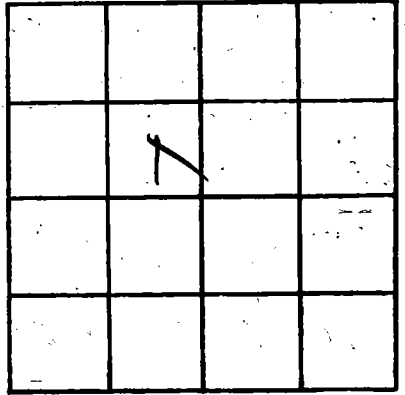

SECTION _____

Please indicate well location X.

ADDITIONAL INFORMATION

Horizontal lines for providing additional information.

If more than one screen, show locations of each on sketch.