

JACKSON

E 42

5-5-71

MISSISSIPPI BOARD OF WATER COMMISSIONERS
416 North State Street
Jackson, Mississippi 39201

CODED

WATER WELL DRILLERS LOG

5/5/71
date well completed

Coastal Drilling Co.
firm name

Jackson
county well located

LANDOWNER: Enj. Savine
RT 5

description of formations encountered	from	to
Top Soil	1	5
Red Clay	5	19
glauca	19	25
White Sand	25	40
hard Blue Clay	40	305
fine white sand	305	340
Red water sand	340	379

Ocean Springs, Miss.
(mailing address)

WELL LOCATION:
sec. 11 T. 5 N. R. 9 E.
5 miles NW of Galiner
(distance) (direction) (nearest town)

WELL PURPOSE: dom
(home, irrigation, municipal, industrial)

- WELL COMPLETION DATA:
- (1) diameter (inches) 2 1/2
 - (2) total depth (feet) 379
 - (3) static water level (feet) 23 below top of ground.
 - (4) casing Flu. 369
(material) (depth)
 - (size) If telescope see back.
 - (5) screen 10' 369
(length) (depth to top)
 - 2 1/2 SS
(size) (material)
 - (6) pump one 17
(HP) (yield gpm)
 - Electric
(type power)
 - (7) electric log no
(yes or no)
 - (organization running log)

CODED

(8) how well bottom plugged
2nd last wash valve


DRILLERS REMARKS:
None

MAY 18 1971

MISS. BD. OF WATER COMM.

If well telescopes please sketch and show depths.

GROUND LEVEL

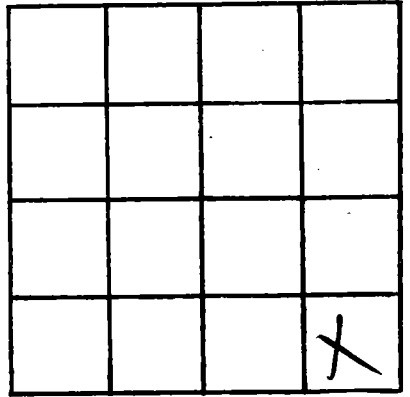

SECTION _____

Please indicate well location X.

ADDITIONAL INFORMATION

If more than one screen, show locations of each on sketch.