

JACKSON
E-43
6-15-71

MISSISSIPPI
BOARD OF WATER COMMISSIONERS
416 North State Street
Jackson, Mississippi 39201

CODED

WATER WELL DRILLERS LOG

6-15 1971 Switzer Well Co. JACKSON
date well completed firm name county well located

LANDOWNER: <u>A.R. Brodnax</u>	description of formations encountered	from	to
<u>Rt. 1 Box 297</u>	<u>red clay</u>	<u>0</u>	<u>13</u>
<u>Ocean Springs, Miss.</u> (mailing address)	<u>fine sand + gravel</u>	<u>13</u>	<u>105</u>
WELL LOCATION: <u>sec. 3 T. 5 S. R. 9 W.</u> <u>13</u> miles <u>N</u> of <u>Biloxi</u> (distance) (direction) (nearest town)	<u>blue clay</u>	<u>105</u>	<u>184</u>
WELL PURPOSE: <u>Home</u> (home, irrigation, municipal, industrial)	<u>sand, coarse</u>	<u>184</u>	<u>199</u>
WELL COMPLETION DATA:	<u>sand</u>	<u>199</u>	<u>214</u>
(1) diameter (inches) <u>2"</u>	<u>clay</u>	<u>214</u>	<u>341</u>
(2) total depth (feet) <u>446'</u>	<u>sand</u>	<u>341</u>	<u>351</u>
(3) static water level (feet) <u>88'</u> <u>below</u> top of ground.	<u>clay</u>	<u>351</u>	<u>415</u>
(4) casing <u>galv.</u> , <u>446'</u> , (material) (depth) <u>(size)</u> if telescope see back.	<u>sand</u>	<u>415</u>	<u>446</u>
(5) screen <u>10'</u> , <u>436'</u> (length) (depth to top)			
<u>008</u> , <u>stainless steel</u> (size) (material)			
(6) pump <u>1</u> , <u>1.3</u> (HP) (yield gpm)			
<u>ELECTRIC</u> (type power)			
(7) electric log <u>No</u> (yes or no)			
(organization running log)			
(8) how well bottom plugged <u>back</u> <u>pressure valve.</u>			
DRILLERS REMARKS:			


CODED

AUG 1 1971

MISS. BD. OF
WATER COM.

If well telescopes please sketch and show depths.

GROUND LEVEL

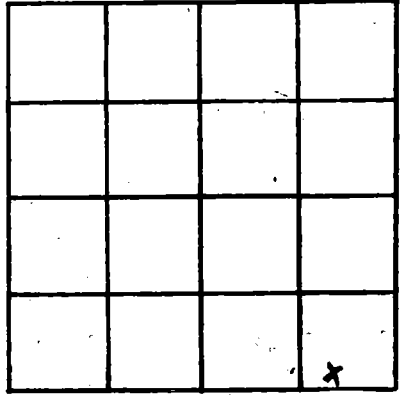

SECTION 3

Please indicate well location X.

ADDITIONAL INFORMATION

A series of horizontal lines for writing additional information, starting below the 'ADDITIONAL INFORMATION' header and extending to the bottom of the page.

If more than one screen, show locations of each on sketch.