

JACKSON
E 46
2-11-74

MISSISSIPPI
BOARD OF WATER COMMISSIONERS
416 North State Street
Jackson, Mississippi 39201

CODED

WATER WELL DRILLERS LOG

COASTAL DRILLING & SERVICE CO.

2/11 1974 date well completed
ROUTE 1 BOX 618
firm name
BILOXI, MISS. 39532

Jackson
county well located

LANDOWNER: Mike M...
109 Rice track rd
Biloxi, Miss
(mailing address)

description of formations encountered	from to	
top soil	1	3
Red clay	3	10
gray white sand	70	70
Soft Blue clay	70	220
hard blue clay	220	440
Case water sand	440	470
fine water sand	470	485
Case water sand	485	527

WELL LOCATION:
sec 37 T 5 N R 9 E
S W
(3) Three miles N Latimer
(distance) (direction) (nearest town)

WELL PURPOSE: home
(home, irrigation, municipal, industrial)

WELL COMPLETION DATA:

- (1) diameter (inches) 2"
- (2) total depth (feet) 527'
- (3) static water level (feet) 25' below top of ground
- (4) casing PVC 517' (material), (depth)
- (5) screen 10' 517' (length) (depth to top)
2" PVC (size) (material)
- (6) pump 1/2 (HP) 15 (yield gpm)
ELe (type power)
- (7) electric log no (yes or no)

CODED

(organization running log)

(8) how well bottom plugged 2"
back with water


DRILLERS REMARKS: none

RECEIVED
AUG 15 1974

MISS. BD. OF WATER COMM

If well telescopes please sketch and show depths.

GROUND LEVEL

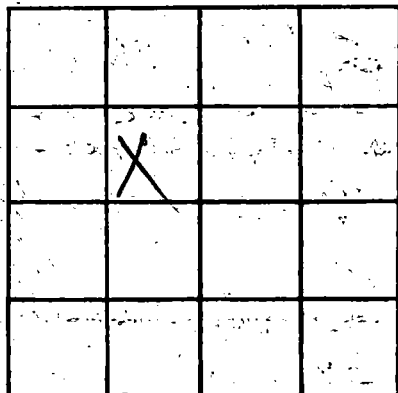

SECTION 34

Please indicate well location X.

ADDITIONAL INFORMATION

If more than one screen, show locations of each on sketch.