

JACKSON
E 47
1-31-75

MISSISSIPPI
BOARD OF WATER COMMISSIONERS
416 North State Street
Jackson, Mississippi 39201

CODED

WATER WELL DRILLERS LOG

31 JANUARY 19 75 GARLAND WATER WELLS JACKSON
date well completed firm name county well located

LANDOWNER: RAYMOND PAGE
HUMPHRIES ROAD
Vancouver Ms.
(mailing address)

WELL LOCATION:
sec. 26 T. 15 S. R. 9 E. 35
11 miles North of Ocean Springs
(distance) (direction) (nearest town)

WELL PURPOSE: Home
(home, irrigation, municipal, industrial)

- WELL COMPLETION DATA:
- diameter (inches) 2"
 - total depth (feet) 386'
 - static water level (feet) 48' below above top of ground.
 - casing P.V.C. 376'
(material) (depth)
2"
(size) if telescope see back.
 - screen 10' STEEL
(length) 386'-376'
2" STAINLESS STEEL
(size) (material)
 - pump 1/2 8
(HP) (yield gpm)
Electric
(type power)
 - electric log NO
(yes or no)
N/A
(organization running log)
 - how well bottom plugged FLAT
BACK

| description of formations encountered | from | to |
|---------------------------------------|------|-----|
| TOP SOIL | 0 | 15 |
| MED. SAND | 15 | 55 |
| CLAY | 55 | 94 |
| MED. SAND | 94 | 100 |
| STREAKS - CLAY + SAND | 100 | 135 |
| MED. SAND | 135 | 185 |
| STREAKS CLAY + SAND | 185 | 220 |
| BLUE CLAY | 220 | 326 |
| MED. TO COARSE SAND | 326 | 386 |

CODED


RECORDED
INDEXED
FEB 14 1975

DRILLERS REMARKS:

FEB 14 1975

If well telescopes please sketch and show depths.

GROUND LEVEL

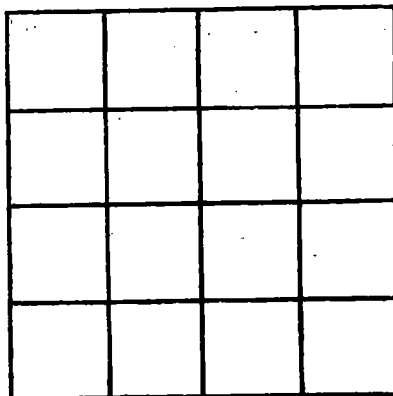

SECTION _____

Please indicate well location X.

ADDITIONAL INFORMATION

If more than one screen, show locations of each on sketch.