

JACKSON
E48
9-16-74

MISSISSIPPI
 BOARD OF WATER COMMISSIONERS
 416 North State Street
 Jackson, Mississippi 39201

CODED

WATER WELL DRILLERS LOG

9/16 1974 COAST WATER WELL SERVICE Jackson
 date well completed firm name county well located

LANDOWNER: O. H. Wilson
Rt. 1 Box 133
Ocean Springs, Mo.
 (mailing address)
 WELL LOCATION:
 sec 2 T 5 S R 8 W
8 1/2 miles N.W. of Vanhook
 (distance) (direction) (nearest town)

description of formations encountered	from	to
<u>top soil</u>	<u>0</u>	<u>21</u>
<u>Sand - C</u>	<u>21</u>	<u>30</u>
<u>Blue Clay</u>	<u>30</u>	<u>107</u>
<u>Sand - F</u>	<u>107</u>	<u>120</u>
<u>Blue Clay</u>	<u>120</u>	<u>150</u>

WELL PURPOSE: Home
 (home, irrigation, municipal, industrial)

<u>Sand - F</u>	<u>150</u>	<u>162</u>
-----------------	------------	------------

WELL COMPLETION DATA:
 (1) diameter (inches) 2"
 (2) total depth (feet) 330'
 (3) static water level (feet) 125 below top of ground
 (4) casing PVC, 330'
 (material) (depth)
2" if telescope see back.
 (size)
 (5) screen 10', 320'
 (length) (depth to top)
2", PVC
 (size) (material)
 (6) pump 2 8
 (HP) (yield gpm)
elec.
 (type power)
 (7) electric log No
 (yes or no)
 (organization running log)
 (8) how well bottom plugged
B.W.V.

<u>Blue Clay</u>	<u>162</u>	<u>238</u>
<u>Sand - M</u>	<u>238</u>	<u>250</u>


DRILLERS REMARKS:

MAY 16 1975

FR COMM

If well telescopes please sketch and show depths.

GROUND LEVEL

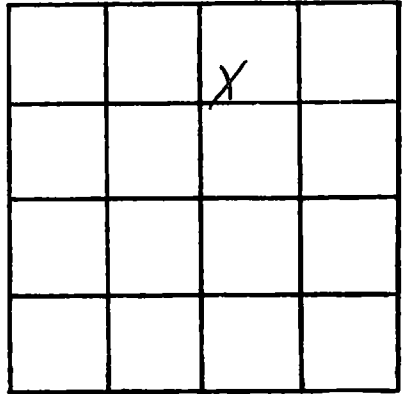

SECTION 2

Please indicate well location X.

ADDITIONAL INFORMATION

If more than one screen, show locations of each on sketch.