

MISSISSIPPI DEPARTMENT OF NATURAL RESOURCES

Bureau of Land and Water Resources

Southport Mall

P.O. Box 10631

Jackson, Mississippi 39209

WATER WELL DRILLERS LOG

COULD

JACKSON
E 50
3-18-81

3-18-
date well completed

81 Coast Water Well Sew.
firm name

Jackson
county well located

LANDOWNER: *Ann Wilkerson*
Rt 1 - Box 98 B.
Ocean Springs, Miss
(mailing address) 39564

description of formations encountered	from	to
<i>Top soil</i>	<i>0</i>	<i>1'</i>
<i>Red Clay</i>	<i>1</i>	<i>10'</i>
<i>Purple Clay</i>	<i>10'</i>	<i>30'</i>
<i>Gray Clay</i>	<i>30'</i>	<i>40'</i>
<i>Blue Clay</i>	<i>40'</i>	<i>60'</i>
<i>Red Coarse sand & gravel</i>	<i>60'</i>	<i>110'</i>

WELL LOCATION:
sec. *13* T. *5* S. R. *9* W.
6 miles (distance) *N* (direction) of *LATIMER* (nearest town)

WELL PURPOSE: *None*
(home, irrigation, municipal, industrial)

- WELL COMPLETION DATA:
- (1) diameter (inches) *2"*
 - (2) total depth (feet) *110'*
 - (3) static water level (feet) *55'* below top of ground.
 - (4) casing *PVC* (material), *100'* (depth)
2" (size) If telescope see back.
 - (5) screen *PVC* (length), *100'* (depth to top)
2" (size), *PVC* (material)
 - (6) pump *1HP.* (HP), *-8-* (yield gpm)
Electric (type power)
 - (7) electric log *No-* (yes or no)

(organization running log)

(8) how well bottom plugged
Back Wash Valve

DRILLERS REMARKS:


DEPT. OF NATURAL RESOURCES
BUREAU OF LAND & WATER RESOURCES

APR - 9 1981

RECEIVED

If well telescopes please sketch and show depths.

GROUND LEVEL

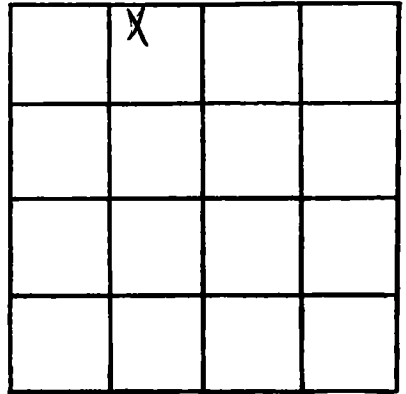

SECTION 13

Please indicate well location X.

ADDITIONAL INFORMATION

If more than one screen,
show locations of each on sketch.