

# State Well Report

## Part 1

Mississippi Department of Environmental Quality  
Office of Land and Water Resources  
P.O. Box 10631  
Jackson, MS 39289-0631  
(601)961-5210  
(601)354-6938 (fax)

**For Office Use Only:**

Aquifer: \_\_\_\_\_  
Well #: E-124  
L. S. Elevation: \_\_\_\_\_  
E-log #: \_\_\_\_\_

County: JACKSON  
Permit #: \_\_\_\_\_  
Driller: Coast Water Wells SRV  
Date drilling completed: 9-1-06

**State Law requires that this report be prepared by the driller in detail and filed with the Department within 30 days of completion of drilling of the well.**

Well Owner Information	Well Location
Owner Name: <u>Robert + Meyers</u>	Latitude: <u>30° 38' 09.6"</u> Longitude: <u>088° 47' 59.8"</u>
Mailing Address: <u>KITO LANE</u>	Method of Lat/Long (circle one): Conventional Survey, USGS quad, <u>Hand-held GPS</u> , Survey-grade GPS
<u>Vancleave Ms 39565</u>	<u>NE</u> 1/4 <u>SW</u> 1/4 Sec <u>4</u> Twn <u>T55</u> Rng <u>R8W</u>
City State Zip Code	SE Distance Direction Nearest Town
Telephone No. <u>850 418-5030</u>	<u>9 1/2</u> Miles <u>NW</u> of <u>Vancleave</u>

**Well Data**

Purpose of Well (circle one) Home Industrial Public Supply Irrigation Fish Culture Other: \_\_\_\_\_

Date well drilling started: 8-31-06 Date well drilling completed: 9-1-06

If flowing, method of flow regulation: Valve N/A Other (describe) \_\_\_\_\_

Static Water Level: 115 feet above or below (circle one) land surface Date measured: 9-1-06

Method of Measurement (circle one) steel tape electric tape air line other: \_\_\_\_\_

Hole depth: 368' Well depth: 368' Well grouted to a depth of 10 feet

Type of grout (circle one): Cement Bentonite Mix

Casing length: 353 feet Casing diameter: 2 inches Type of casing: PVC

Screen length: 15 feet Screen diameter: 2 inches Type of screen: PVC

Screen slot size: .008 inches Setting depth: From 353 feet to 368 feet

Type of completion (circle all applicable): Gravel packed Underreamed Telescoped Open hole Natural Development

Other (describe): \_\_\_\_\_

Top of lap pipe or reduction in casing: N/A feet. If telescoped or more than one screen, describe on back of page

Logs run (circle all applicable): No log run Electric Gamma Ray Density Sonic Neutron Other: \_\_\_\_\_

Name of organization running log(s): N/A

I certify that the well was drilled, constructed, and completed in accordance with all applicable requirements of the Mississippi Department of Environmental Quality and/or the Mississippi Department of Health regulations and state laws.

Jack Ridgdell 0-472  
Print Name of Water Well Contractor and License No.


Jack Ridgdell RECEIVED  
Signature of Water Well Contractor SEP 25 2006

BY: OLWR

E-124


If well telescopes please sketch below and show depths.

Ground Level

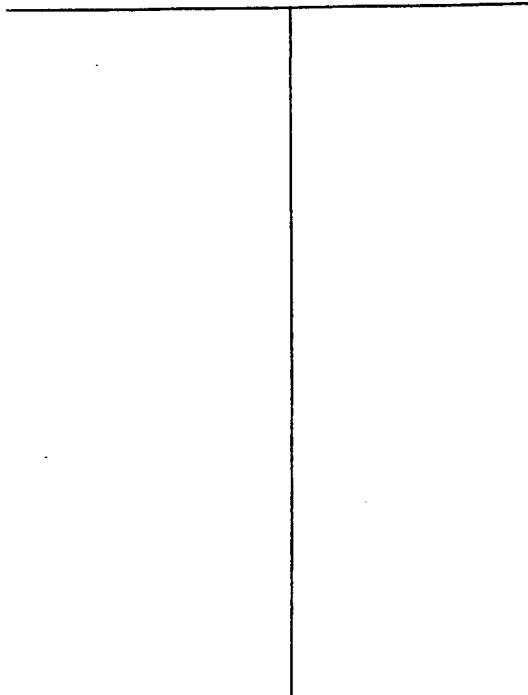

Description of Formations Encountered	From	To
TOP SOIL	0	2
Orange Clay w/streaks of SAND	2	104
Blue Clay w/streaks of Sand	104	343
Gray Coarse Sand	343	368

If more than one screen, show location of each on sketch

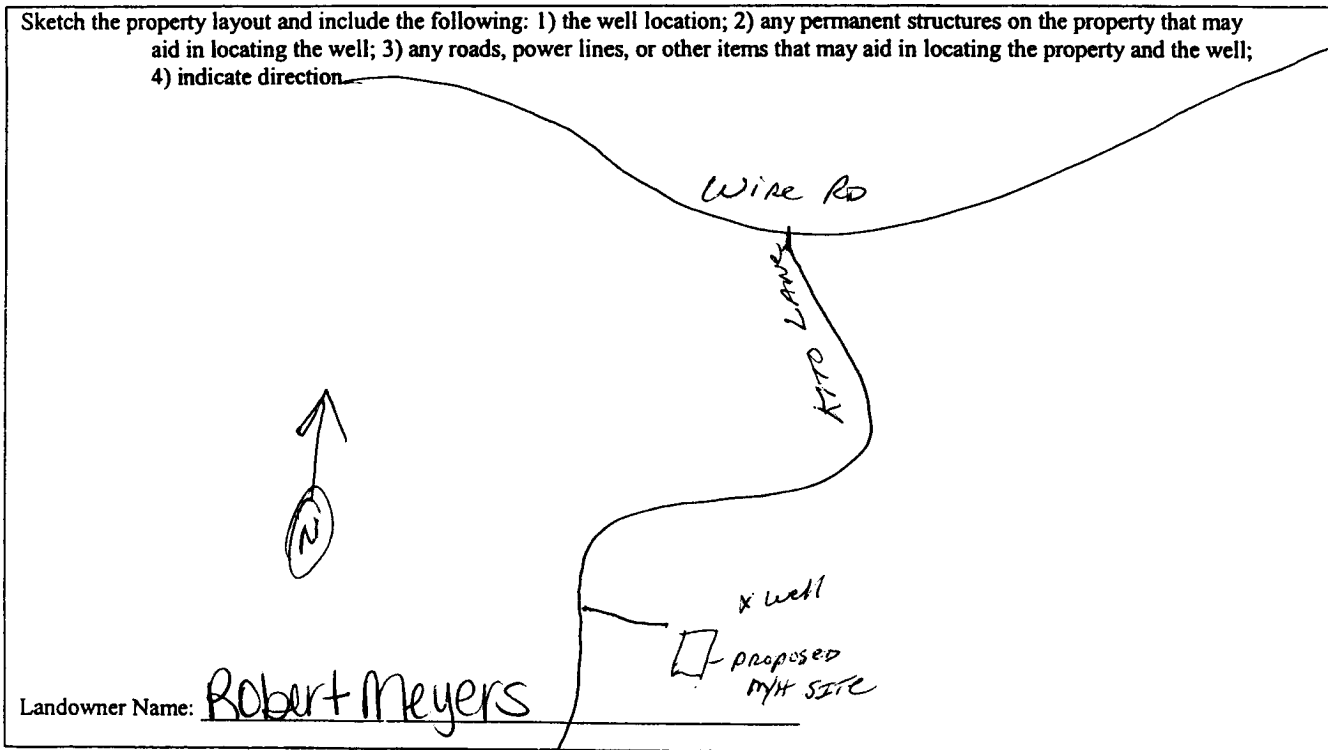

  
Signature of Water Well Contractor

RECEIVED  
SEP 25 2006  
BY: OLWR