County: JACKSON Permit #: Driller(Pa Mississippi Department Office of Land ar P.O. B Jackson, Mi (601)9	ell Report art 1 of Environmental Quality ad Water Resources ox 10631 S 39289-0631 061-5210 6938 (fax)	For Office Use Only: Aquifer:
State Law requires that this rep 30 days of completion of drilling		driller in detail and filed w	ith the Department within
Well Owner Informa Owner Name_William Sher	ition Man	Latitude: <u>30 • 34 ;338</u>	38
Mailing Address: 14200 Bille		Method of Lat/Long (circle on	
Vancleave, A City Stat	NS 39565 te Zip Code	$\frac{N\omega}{N\Xi} \frac{N\omega}{\sqrt{2}} \frac{N\omega}{\sqrt{2}} \frac{V}{\sqrt{2}} \frac{Sec_{2}}{26}$	GPS.) Survey-grade GPS Twn $\underline{T55}$ Rng $\underline{R9W}$ Nearest Town
Telephone No. 638) 697-03	85	$\frac{1}{2}$ Miles $\frac{1}{2}$ Miles	
	Weil D	ata	• • • • • • • • • • • • • • • • • • •
Purpose of Well (circle on Home) Ind Date well drilling started:	3-06 Date we	ell drilling completed:	
Static Water Level: 80 feet ab	ove or below (circle one) la	nd surface Date measured:	10-24-06
Method of Measurement (circle one) st	eel tape electric tape	air line other:	
Hole depth: <u>292'</u> Well dep	oth:	Well grouted to a depth of	feet
Type of grout (circle one): Cement	Bentonite Mix		A
Casing length: 282 feet Casin	ig diameter:	_inches Type of casing:	pvc,
	en diameter:	_inches Type of screen:	<u>pvc</u>
Screen slot size: 1000° inches	Setting depth: From	282feet to	<u>9</u> feet
Type of completion (circle all applicable):	Gravel packed Underre	eamed Telescoped Open	hole Natural Development
	(1 .	····	
Top of lap pipe or reduction in casing:	VAfeet. If tele	scoped or more than one scre	en, describe on back of page
Logs run (circle all applicable) No log rur	Electric Gamma Ray	Density Sonic Neutron (Dther:
Name of organization running log(s):	NA		
I certify that the well was drilled, constru Department of Environmental Quality as		••	• •
Jack Ridadell D.	-410		A Reference in the second state in the second secon
Juni Muguli V		Signature of V	BECEIVE
Print Name of Water Well Contractor and I	LICENSE INO.	Signature of t	water well Chinacter we have
Print Name of Water Well Contractor and I		Signature of	NOV 17 200

•


E-129

If well telescopes please sketch below and show depths.

Ground Level

Description of Formations Encountered	From To
 TOPSOIL	02
Blue clay	12 235
FINEGRAYSand	235/240
Bueclay	<u> </u>
medium GrAy Sand	<u></u>
······································	
	
	<u> </u>
<u> </u>	
	<u></u>

If more than one screen, show location of each on sketch

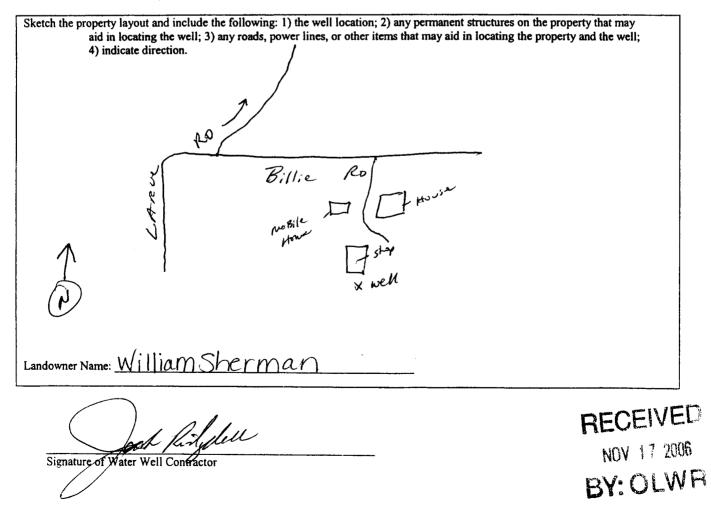

STATE	WELL REPORT	
Mississippi Depa	Part 2 aller's Completion Report artment of Environmental Quality Land and Water Resources	:
Driller OUST WATER UCTION Jacks	P.O. Box 10631 son, MS 39289-0631 (601)961-5210 01)354-6938 (fax) Elevation:	
	n detail and filed with the Department within 30 days of the	
installation of pump. Well Owner Information	Well Location	<u></u>
Owner Name: William Sherman	Latitude: 30°34′338′Longitude: 088°50′(23
Mailing Address: 1420 Billie, Rd.	Method of Lat/Long (circle one): Conventional Survey,	
	USGS quad, (Hand-held GPS) Survey-grade GI	PS
Vancleave MS 39565	NW 1/4 NW 1/4 Sec 36 Twn 755 Rng R9	<i>w</i>
City State Zip Code	Distance Direction Nearest Town	
Telephone No. 228 697-0385	10 Miles WNW of VANdence	
Pump Type Circle one	Power Type Circle one	
Air Lift (Jet) Submersible	Diesel Engine Gasoline Engine Natural C	las
Bucket Piston Turbine	Electric Motor Hand Tractor P	
Centrifugal Rotary Flowing Well	Windmill Other (specify):	
Other (specify):	Horse Power Rating of Motor:	_
Date Pump Installed: 10-25-06	Setting Depth: 100 FT. Drop pipe_feet	
Rated Pump Capacity: Gallons Per Minute		
Pump Test Data	Method of Measuring Water Level Circle one	
Date Well Tested:		
Static Water Level (A):Feet Below Land Surface	Other (specify):	
Pumping Water Level (B): <u>N/A</u> Feet Below Land Surface		
Drawdown [(B) – (A)]: N/A Feet Below Land Surface	For flowing well, measured shut in head: $\frac{N/A}{F}$ fe	et
Test Pumping Rate:Gallons Per Minute		
Duration of Pump Test (minimum 4 hours): hours	<u>N/A</u> feet after <u>N/A</u> hours of pumpi	ng
I HEREBY CERTIFY that the above statements are true to the b <u>JACK Ridgdell 0-47</u> Print Name of Pump Installer and License No. (if applicable)	Signature of Pump Installer NOV 17	\V +γ

•