	ell Report	For Office Use Only:				
Countral AL AL STORE	art 1					
	t of Environmental Quality and Water Resources	Aquifer: Well #: <u>E-140</u>				
Deillard LLAS DE TWATCH VIN 11/ NEV	Box 10631					
Jackson, N	IS 39289-0631 961-5210	L. S. Elevation:				
(601)35	4-6938 (fax)	E-log #:				
State Law requires that this report be prepared by the driller in detail and filed with the Department within 30 days of completion of drilling of the well.						
Well Owner Information		Location				
Owner Name Bill Wilson		" Longitude <u>88.47.687</u> "				
Mailing Address: 13600 COUNTY Trail	Method of Lat/Long (circle or	(he): Conventional Survey, 71				
	USGS quad, Hand-held	GPS, Survey-grade GPS				
VANCLEAVE. 175 39565 City State Zip Code	NG 1/4 NW 1/4 Sec 29	Twn 735 Rng R8W				
Telephone No. 2018 990 - 0006	Distance Direction $Miles$	Nearest Town of				
Well I)ata					
Purpose of Well (circle one) Home Industrial Public Supply	Irrigation Fish Culture	Other:				
Date well drilling started: 5-9-07 Date w	vell drilling completed:	-10-07				
If flowing, method of flow regulation: Valve NA Other (d	escribe)					
Static Water Level:	and surface Date measured:_	8-10-07				
Method of Measurement (circle one) steel tape electric tape air line other:						
Hole depth: <u>379FT</u> Well depth: <u>379FT</u>	Well grouted to a depth of	<u> </u>				
Type of grout (circle one): Cement Bentonite Mix		2.10				
Casing length: <u>369</u> feet Casing diameter: <u>3</u>	inches Type of casing:	PK.				
Screen length: <u>IC</u> feet Screen diameter: <u>S</u> inches Type of screen: <u>PVC</u>						
Screen slot size: <u>, CO6</u> inches Setting depth: From <u>369</u> feet to <u>379</u> feet						
Type of completion (circle all applicable): Gravel packed Underreamed Telescoped Open hole Natural Development						
Other (describe):						
Top of lap pipe or reduction in casing: N/A feet. If tel	escoped or more than one scre	een, describe on back of page				
Logs run (circle all applicable): No log run Electric Gamma Ray	Density Sonic Neutron	Other:				
Name of organization running log(s): NA						
I certify that the well was drilled, constructed, and completed in a Department of Environmental Quality and/or the Mississippi Dep						
Thek Richardell 0-1172		And State Laws.				
Print Name of Water Well Contractor and License No.	Signature of	Water Well Contractor				
		AUG 27 2007				

BYCLWE

1

۰.

*


8-140

If well telescopes please sketch below and show depths.

Ground Level

Description of Formations Encountered	From	То
 TODSOIL	$\Box O$	る
Orange Coarse sand	12	8
Drunge, Clay	8	54
White Coarse Sarry N/peagravel	54	109
BueClay	109	129
Gray Coarse Sand	309	379
pinfunisesere		
	+	
	+	
	<u> </u>	
	_	L
	\square	L
	T	
	1	
	1	
	J	L

If more than one screen, show location of each on sketch

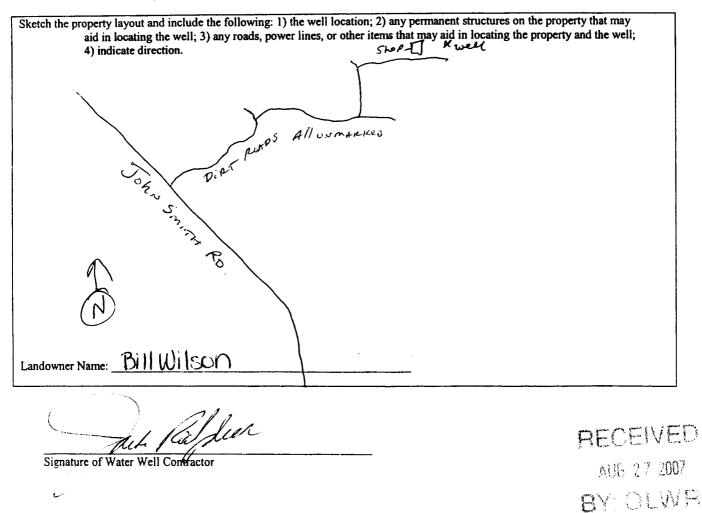

	STATE W	ELL REPORT	
County: Jackson	Part 2 Pump Installer's Completion Report Mississippi Department of Environmental Quality Office of Land and Water Resources P.O. Box 10631 Jackson, MS 39289-0631		For Office Use Only:
			Aquifer:
Permit #: Driller: Cast Water Well SRV.			well #: E-140
Date completed: 8-10-07	(601)961-5210 54-6938 (fax)	Elevation:
This report should be prepared by th installation of pump.	be pump installer in deta	ail and filed with the Departm	nent within 30 days of the
Well Owner Information			ell Location
Owner Name: Bill Wilson		Latitude: 30 35 03	Longitude: <u>U88° 47'68</u>
Mailing Address: 13600 Country Trail		Method of Lat/Long (circle	one): Conventional Survey,
$\overline{\mathbf{A}}$			nd-heid GPS Survey-grade GPS
Vancicave. Mis 37545 City State Zip Code		<u>NE 1/2 NW 1/2 Sec 29 Twn 755 Rng R8W</u>	
	•	Distance Direction	Nearest Town
Telephone No. 238990 - 0336		\underline{S} Miles \underline{W}	of Varkave
Ритр Туре		P	ower Type
Circle one		1	Circle one
Air Lift (Jet)	Submersible		ine Engine Natural Gas
Bucket Piston	Turbine	Electric Motor Hand	
Centrifugal Rotary	Flowing Well		(specify):
Other (specify):		Horse Power Rating of Motor: <u><u>AHP</u> Setting Depth: <u>100 FT. Drop pipe</u> feet</u>	
Date Pump Installed: 8-11-07			
Rated Pump Capacity: <u>9,5</u>	Gallons Per Minute	Number of Stages: 3	
Pump Test Data			easuring Water Level
Date Well Tested: 8-11-01	······		asuring Line Steel Tape
Static Water Level (A):Feet Below Land Surface		Other (specify):	
Pumping Water Level (B): <u>N/A</u> Feet F	Below Land Surface	Said (apony)	1
Drawdown [(B) – (A)]: \underline{NA} Feet 1	Below Land Surface	For flowing well, measured s	hut in head: N/A feet
	Gallons Per Minute	1	GPM with a drawdown of
Duration of Pump Test (minimum 4 hours):	hours	N/A feet after	N/A hours of pumping
HEREBY CERTIFY that the above statemed JOCK RIDGCEII 0-4	enus are true to the best of	my knowledge.	he los
Print Name of Pump Installer and License N	o. (if applicable)	Signature of Pump In	nstaller propint
			AUG 27 X

•

BY OLWE