State	e Well Report			
County: Jackson	Part 1	For Office Use Only:		
Mississippi Depar	tment of Environmental Quality	Aquifer:		
Porch la Corrigation P	and and Water Resources .O. Box 10631	Well #: E-145		
Drillet UDT WUTCI WEIJSKV Jackso	on, MS 39289-0631	L. S. Elevation:		
	601)961-5210 1)354-6938 (fax)	E-log #:		
State Law requires that this report be prepared by the driller in detail and filed with the Department within 30 days of completion of drilling of the well.				
Well Owner Information		Location		
Owner Name Christialker	· // /	Latitude: <u>30°38' 703</u> " Longitude: <u>088° 49' 779</u> "		
Mailing Address: Decohoreluff CIr		e): Conventional Survey, 97		
		GPS, Survey-grade GPS		
Vancleave MS 39565 City State Zip Code	NW1/2 NW1/2 Sec_6	Twn T55 Rng RSW		
Telephone No. $\frac{\partial B}{\partial C} \frac{\partial C}{\partial C} - \frac{\partial C}{\partial C} \frac{\partial C}{\partial C}$	Distance Direction	Nearest Town of <u>Warcleave</u>		
	Vell Data			
Purpose of Well (circle one Home Industrial Public Supply Irrigation Fish Culture Other:				
Date well drilling started: <u>9-19-07</u> Date well drilling completed: <u>9-20-07</u>				
If flowing, method of flow regulation: Valve <u>N/r</u> Other (describe)				
Static Water Level: <u>80</u> feet above or felow (circle one) land surface Date measured: <u>9-30-07</u>				
Method of Measurement (circle one) steel tape electric tape air line other:				
Hole depth: <u>270FT</u> Well depth: <u>270FT</u> Well grouted to a depth of <u>10</u> feet				
Type of grout (circle one): Cement Bentonite Mix				
Casing length: 200 feet Casing diameter: 2 inches Type of casing: PVC				
Screen length: 10 feet Screen diameter: 2 inches Type of screen: PVC				
Screen slot size: . Old inches Setting depth: From <u>Scoo</u> feet to <u>370</u> feet				
Type of completion (circle all applicable): Gravel packed Underreamed Telescoped Open hole Natural Development				
Other (describe):				
Top of lap pipe or reduction in casing: $\frac{N/A}{A}$ feet. If telescoped or more than one screen, describe on back of page				
Logs run (circle all applicable): No log run Electric Gamma Ray Density Sonic Neutron Other:				
Name of organization running log(s): NIA I certify that the well was drilled, constructed, and completed in accordance with all applicable requirements of the Mississippi				
Department of Environmental Quality and/or the Mississippi Department of Health regulations and state laws.				
Tark Dilatella 1		. 111.		
JUCK HODDELL 0-472-	Auk	Kilde		
Print Name of Water Well Contractor and License No.	Signature of	Water Well Constactor		
		OCT 1 \$ 2007		

BY: OLWR


8-145

If well telescopes please sketch below and show depths.

Ground Level

Level		Description of Formations Encountered		To
Level		)Soil	0	ð
	ora	nge + Blue Clay, mediumsand	a	80
	Gre	- madium Sadd	80	95
		P Clay	95	15
		And Lunch C a not	775	270
	Gra		- que	
				<b></b>
	· · · · · · · · · · · · · · · · · · ·			
				<b>├</b> ───┤
				——————————————————————————————————————
		······································		
l				

If more than one screen, show location of each on sketch

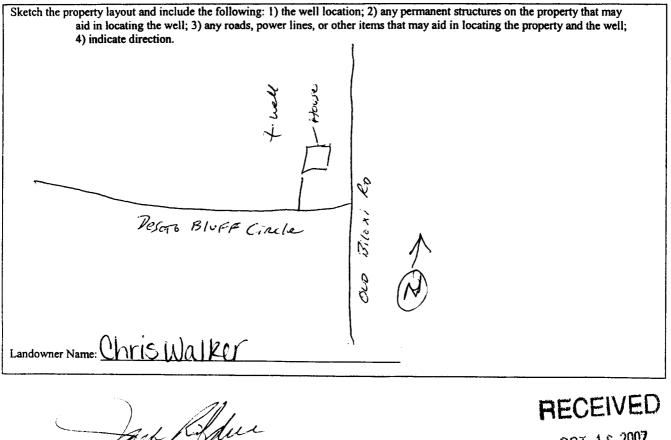

Signature of Water Well Contractor

ί

OCT 16 2007 BY: OLWR

STATE WELL REPORT				
Permit #: Mississippi Departs Driller COOST Water WellSRV Date completed: 9-20-07 (6	Part 2 For Office Use Only:   her's Completion Report Aquifer:   ment of Environmental Quality Aquifer:   0. Box 10631 Well #: £-145   n, MS 39289-0631 Elevation:   0354-6938 (fax) Elevation:			
This report should be prepared by the pump installer in d installation of pump.	letail and filed with the Department within 30 days of the			
Well Owner Information	Well Location			
Owner Name: Chris Walker	Latitude: <u>38' 703''</u> Longitude: <u>088° 49' 77</u> 9''			
Mailing Address: Desoto Bluff Cir	Method of Lat/Long (circle one): Conventional Survey,			
	USGS quad, fand-heid GPS Survey-grade GPS			
Vancleave, M5 39565 City State Zip Code	$\frac{N\omega}{N} \frac{N\omega}{N} \frac$			
Telephone No. (2018) 209 - Ologo	Distance Direction Nearest Town			
Telephone No. (2010) CN 1~ LOGO	I Miles NW of VANILEANE			
Ритр Туре	Power Type			
Circle one	Circle one			
Air Lift Jet Submersible	Diesel Engine Gasoline Engine Natural Gas			
Bucket Piston Turbine	Electric Motor Hand Tractor PTO			
Centrifugal Rotary Flowing Well	Windmill Other (specify):			
Other (specify):	Horse Power Rating of Motor: 2H			
Date Pump Installed: 9-21-07	Setting Depth: 100FT. Droppipefeet			
Rated Pump Capacity: 9 Gallons Per Minute	Number of Stages:			
Pump Test Data	Method of Measuring Water Level Circle one			
Date Well Tested: <u>4-21-07</u>	Air Line Electric Measuring Line Steel Tape			
Static Water Level (A): $\underbrace{\$0}_{1}$ Feet Below Land Surface	Other (specify):			
Pumping Water Level (B): NA Feet Below Land Surface				
Drawdown $[(B) - (A)]$ : Feet Below Land Surface	For flowing well, measured shut in head:			
Test Pumping Rate:Gallons Per Minute	Well yielded GPM with a drawdown of			
Duration of Pump Test (minimum 4 hours):	N/A feet after $N/A$ hours of pumping			
I HEREBY CERTIFY that the above statements are true to the best	t of my knowledge.			
Print Name of Pump Installer and License No. (if applicable)	Signature of Pump Installer RECEIVED			
	DET 15 2007			
	BY: OLWR			

**`**#

.

.

۰.