	State W	ell Report	For Office Use Only:		
County: Jackson		art 1			
Permit #:	Mississippi Departmen	t of Environmental Quality nd Water Resources	Aquifer:		
Driller Coast Water Wellser		Box 10631	Well #:E166		
		IS 39289-0631	L. S. Elevation:		
Date drilling completed: <u>7-25-09</u>	· · ·	961-5210 4-6938 (fax)	E-log #:		
State Law requires that this repo 30 days of completion of drilling	rt be prepared by the of the well.	driller in detail and filed w	with the Department within		
Well Owner Informat			I Location		
Owner Nam Gary Henze		Latitude: 30 . 36 . 60	2' Longitude 88. 44, 191 "		
Mailing Address: P.O. Box 159	4	3(Method of Lat/Long (circle or	0 1 1		
		USGS quad, Hand-held	GPS Survey-grade GPS		
Gautiers Ms	39553	NWS1/4 SW1/4 Sec 13	V Twn T55 Rng R8W		
City State Telephone No. <u>238) 219-2084</u>	e Zip Code	Distance Direction	Nearest Town of <u>Vanc leave</u>		
	Well	L Data	Dirst Pit		
Purpose of Well (circle one) Home Indu	strial Public Supply	Irrigation Fish Culture	Other: TRICK WASK down		
Date well drilling started: <u>7 - 23-0</u>	Date v	vell drilling completed:	1-25-09		
If flowing, method of flow regulation: Valv	re NA Other (d	escribe)			
Static Water Level: 40, feet abo	ve or below (circle one)	and surface Date measured:	7-25-09		
Method of Measurement (circle one) ste	el tape electric tape	air line other:			
Hole depth: 121 FT. Well dept	h: 131 FT.	Well grouted to a depth of	10 feet		
	Bentonite Mix		0.1		
Casing length:feet Casin	g diameter:	inches Type of casing:			
Screen length: <u>10</u> feet Scree	n diameter: 4	inches Type of screen:	PUC		
Screen slot size: •008 inches	Setting depth: From _	feet to	12 feet		
Type of completion (circle all applicable):	Gravel packed Under	reamed Telescoped Open	hole Natural Development		
	Other (describe):				
Top of lap pipe or reduction in casing:	heet. If te	lescoped or more than one scr	een, describe on back of page		
Logs run (circle all applicable) No log run		Density Sonic Neutron	Other:		
Name of organization running log(s): I certify that the well was drilled, constru	NA	accordance with all applicable	requirements of the Mississippi		
Department of Environmental Quality and	-				
Jack Ridgdell C)-472	ah	hilden		
Print Name of Water Well Contractor and I	icense No.	Signature of			
		U U	. ว. สามารถสาย สามารถสาย 1955 (1996) เป็นสายเหตุ ที่สาย		

1

AUS 1 2 2009

BY: OLWA


BY: OLVER

If well telescopes please sketch below and show depths.

Groun

ind Level	Description of Formations Encountered	From	T₀ [2]
	prange. Clay brange.coarse.sand	15 95	95 Zal

If more than one screen, show location of each on sketch

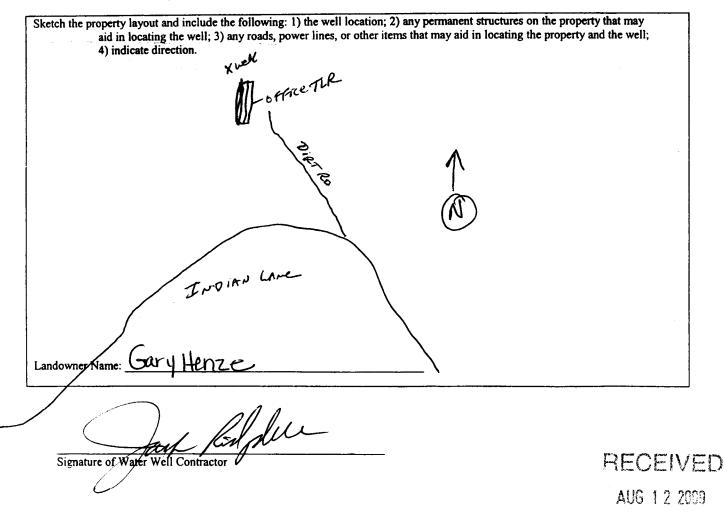

	ELL REPORT			
County: Jackson Pump Installer Permit #: Mississippi Departme Driller: COAST-Water Wellsr P.O. Date completed: 7-25-07 (60)	Part 2 For Office Use Only: P's Completion Report Aquifer: and Water Resources Weil #:			
This report should be prepared by the pump installer in det installation of pump.	Well Location			
Well Owner Information Owner Name: Gary Henze Mailing Address:	Well Location Latitude 30 36 606 "Longitude: 088°44" 791" Method of Lat/Long (circle one): Conventional Survey, 47 USGS quad, Hand-held GPS Survey-grade GPS <u>NW 1/2 SW 1/4 Sec 13 Twn T 55 Rng R8 W</u> Distance Direction Nearest Town <u>6 1/2 Miles NW of VAncleane</u>			
Pump Type Circle one	Power Type Circle one			
Air Lift Jet Submersible	Diesel Engine Gasoline Engine Natural Gas			
Bucket Piston Turbine	Electric Motor Hand Tractor PTO			
Centrifugal Rotary Flowing Well Other (specify): Date Pump Installed:Oq Rated Pump Capacity:Gallons Per Minute	Windmill Other (specify): Horse Power Rating of Motor:			
Pump Test Data	Method of Measuring Water Level			
Date Well Tested: $1-27-09$ Static Water Level (A): 40 Feet Below Land Surface Pumping Water Level (B): $1/4$ Feet Below Land Surface Drawdown [(B) – (A)]: $1/4$ Feet Below Land Surface Test Pumping Rate: 22 Gallons Per Minute Duration of Pump Test (minimum 4 hours): 4 hours	Circle one Air Line Electric Measuring Line Steel Tape Other (specify): For flowing well, measured shut in head: $\frac{N/A}{A}$ feet Well yielded GPM with a drawdown of $\frac{N/A}{A}$ feet after N/A hours of pumping			
I HEREBY CERTIFY that the above statements are true to the best JACK RIDGELL 0-477 Print Name of Pump Installer and License No. (if applicable)	of my knowledge. Senature of Pump Installer RECEIV AUS 1 2 20			

•

.

3	Y		\bigcirc	1	V	V	F	2
345	-	۶.		A.me	×.	N .	£	