		ell Report	For Office Use Only:
County: Jackson		art 1 t of Environmental Quality	Aquifer:
Permit #:	Office of Land a	nd Water Resources	Well #: E165
DrillerCoast Water WellsRU		Box 10631	
Date drilling completed: 8-4-09	Jackson, IV	IS 39289-0631 961-5210	L. S. Elevation:
		4-6938 (fax)	E-log #:
State Law requires that this re 30 days of completion of drillin	port be prepared by the g of the well.		
Well Owner Inform			Location
Owner Name Mark Thom		Latitude: 30 • 38 83	" Longitude 088 • 49 ,929 "
Mailing Address: Desoto	Bluff circle	Method of Lat/Long (circle or	ne): Conventional Survey,
			GPS, Survey-grade GPS
Vancleave M	<u>)s 39565</u> rate Zip Code	NW 1/2 NW 1/2 Sec 6-	Twn 755 Rng R8W
Telephone No. 008 097.4	1	Distance Direction	Nearest Town of LARVE
	Well	Data	
Purpose of Well (circle on Home) Ir	dustrial Public Supply	Irrigation Fish Culture	Other:
Date well drilling started: 8-4-1	Date v	vell drilling completed:	3-4-09
If flowing, method of flow regulation: V	alve NA Other (d	escribe)	
Static Water Level: <u>95</u> feet a	above or felow (circle one)	and surface Date measured:	8-4-09
Method of Measurement (circle one)	steel tape electric tape	air line other:	
Hole depth: <u>A70FT</u> Well d	epth: 270 FT	Well grouted to a depth of	<u>lo</u> feet
Type of grout (circle one): Cement	Bentonite Mix		
Casing length: <u>255</u> feet Cas	sing diameter:	inches Type of casing:	PVC
Screen length:feet Scr	reen diameter:	inches Type of screen:	P.VC
Screen slot size:	Setting depth: From _	<u>a55</u> feet to a	70 feet
Type of completion (circle all applicable): Gravel packed Under	reamed Telescoped Open	hole Natural Development
	Other (describe):		
Top of lap pipe or reduction in casing:	N/A feet. If te	escoped or more than one scre	en, describe on back of page
Logs run (circle all applicable) No log r	un Electric Gamma Ray	Density Sonic Neutron	Other:
Name of organization running log(s):	NA		
			requirements of the Mississippi
I certify that the well was drilled, cons			
I certify that the well was drilled, cons Department of Environmental Quality		partment of Health regulation	s and state laws.
I certify that the well was drilled, cons		partment of Health regulation	

• 6 at .

AUG	1 4.194	2 21	309
ΒY	C		NR


If well telescopes please sketch below and show depths.

Gr

. .

Ground Level	Description of Formations Encountered	From To
	Grange & Blue clay Gray medium Sand Blue clay Gray Medium to coarse. Sand	2 /50 /50 /80 /80 /35 235 270

If more than one screen, show location of each on sketch

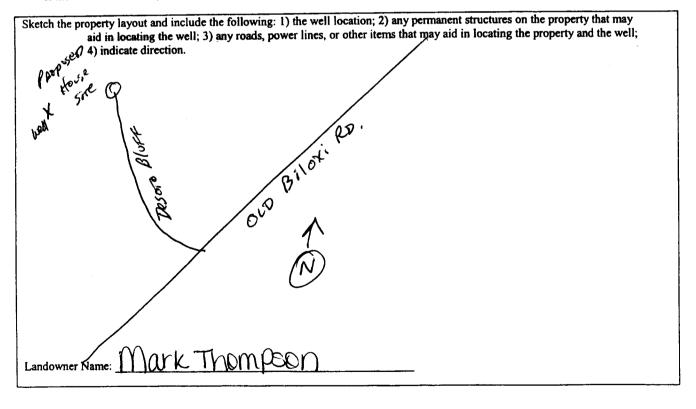

her pur Signature of Water Well Contractor

RECEIVED AUG 1 2 2009 BY: OLWR

County: Discrete Permit #: Pump Installer Driller: Coast Water Wellsr Driller: Cast Water Wellsr County: Coast Water Wellsr	Part 2 S Completion Report Ps Completion Report Aquifer: I and Water Resources Aquifer: Box 10631 MS 39289-0631 1) 961-5210 Elevation: 354-6938 (fax) Elevation: SC Well #: $E 168$ Latitude: $30^{\circ} 38^{\circ} 837$ Conventional Survey, Latitude: $30^{\circ} 38^{\circ} 837$ Conventional Survey, USGS quad, Iand-held GPS Distance Direction Nearest Town $3! 4! 4!''$ ME of $4!'' 5!''$ Power Type Circle one Diesel Engine
installation of pump. Well Owner Information Owner Name: Mat K Thompson Mailing Address: Desoto Bluff Circle Vanc leave. Ms 39565 City State Zip Code Telephone No. 208 297-4820 Pump Type Circle one	Well Location Latitude: 30 38'837 "Longitude: 088'49'929" SC Method of Lat/Long (circle one): Conventional Survey, USGS quad, tand-held GPS Method of Lat/Long (circle one): Conventional Survey, USGS quad, tand-held GPS Method of Lat/Long (circle one): Conventional Survey, USGS quad, tand-held GPS Method GPS Method of Lat/Long (circle one): Conventional Survey, USGS quad, tand-held GPS Method GPS Method GPS Direction Nearest Town 13'14''Miles Method Method GPS Direction Nearest Town 13'14''Miles Method GPS Direction Nearest Town 13'14''Miles Method GPS Circle one
installation of pump. Well Owner Information Owner Name: Mat K Thompson Mailing Address: Desoto Bluff Circle Vanc leave. Ms 39565 City State Zip Code Telephone No. 208 297-4820 Pump Type Circle one	Well Location Latitude: 30 38'837 "Longitude: 088'49'929" SC Method of Lat/Long (circle one): Conventional Survey, USGS quad, tand-held GPS Method of Lat/Long (circle one): Conventional Survey, USGS quad, tand-held GPS Method of Lat/Long (circle one): Conventional Survey, USGS quad, tand-held GPS Method GPS Method of Lat/Long (circle one): Conventional Survey, USGS quad, tand-held GPS Method GPS Method GPS Direction Nearest Town 13'14''Miles Method Method GPS Direction Nearest Town 13'14''Miles Method GPS Direction Nearest Town 13'14''Miles Method GPS Circle one
Owner Name: <u>Mark Thompson</u> Mailing Address: <u>Desoto Bluff Circle</u> <u>Vanc leave Ms 39565</u> <u>City State Zip Code</u> Telephone No. <u>208</u> <u>297-4820</u> <u>Pump Type</u> <u>Circle one</u>	Method of Lat/Long (circle one): Conventional Survey, USGS quad, Land-held GPS Survey-grade GPS <u>Mw 1/4 Nw 1/4 Sec 6 Twn T35 Rng R&W</u> Distance Direction Nearest Town <u>1314</u> Miles <u>NNE</u> of <u>LARVE</u> Circle one
Mailing Address: Desoto Bluff Circle Vancleave Ms 39565 City State Zip Code Telephone No. 208 297-4820 Pump Type Circle one	Method of Lat/Long (circle one): Conventional Survey, USGS quad, Land-held GPS Survey-grade GPS <u>Mw 1/4 Nw 1/4 Sec 6 Twn T35 Rng R&W</u> Distance Direction Nearest Town <u>1314</u> Miles <u>NNE</u> of <u>LARVE</u> Circle one
Vanc leave Ms 39565 City State Zip Code Telephone No. 208 297-4820 Pump Type Circle one	USGS quad, Iand-held GPS Survey-grade GPS $\underline{NW}_{4} \underline{NW}_{4}$ Sec <u>6</u> Twn <u>T55</u> Rng <u>R</u> 8 W Distance Direction Nearest Town <u>1314</u> <u>Miles <u>NNE</u> of <u>LARVE</u> Circle one</u>
City State Zip Code Telephone No. <u>208</u> <u>297-4820</u> Pump Type Circle one	$\frac{N \omega_{1/2} N \omega_{1/4} \operatorname{Sec}_{6} \operatorname{Twn} T \overline{55} \operatorname{Rng}_{8} R \overline{5} \omega}{\operatorname{Distance} \operatorname{Direction} \operatorname{Nearest}_{7} \operatorname{Town}}$ $\frac{13/4}{\operatorname{Miles}} N N \overline{E} \text{ of} L A \overline{D } \overline{V } \overline{2}$ $\frac{\operatorname{Power}_{7} \operatorname{Type}_{Circle \text{ one}}}{\operatorname{Circle one}}$
Pump Type Circle one	Power Type Circle one
Circle one	Circle one
Circle one	Circle one
Air Lift Jet Submersible	Diesel Engine Gasoline Engine Natural Gas
Bucket Piston Turbine	Electric Motor Hand Tractor PTO
Centrifugal Rotary Flowing Well	Windmill Other (specify):
Other (specify):	Horse Power Rating of Motor: 2HP
Date Pump Installed: 8-7-09	Setting Depth: 120FT. Drop Pipe foet
Rated Pump Capacity: <u>9.5</u> Gallons Per Minute	Number of Stages:
Pump Test Data	Method of Measuring Water Level
Date Well Tested: 8-7-09	Circle one
Static Water Level (A):Feet Below Land Surface	Air Line Electric Measuring Line Steel Tape
Pumping Water Level (B): MA Feet Below Land Surface	Other (specify):
Drawdown [(B) – (A)]: N/A Feet Below Land Surface	For flowing well, measured shut in head: N/A feet
Test Pumping Rate: Gallons Per Minute	Well yielded GPM with a drawdown of
Duration of Pump Test (minimum 4 hours):hours	N/A feet after N/A hours of pumping
HEREBY CERTIFY that the above statements are true to the best o	of my knowledge
Jack Ridgdell 0-472	Jain Rigden DECE
Print Name of Pump Installer and License No. (if applicable)	Signature of Pump Installer
	AUG 1

х х х х