
75.11		en Keport	For Office Use Only:				
County LOCKSON		art 1 t of Environmental Quality	Aquifer: 175				
Permit #:	Office of Land a	nd Water Resources					
CostWaterubll	P.O. F	Box 10631	Well #:				
12/alia SRV.		IS 39289-0631	L. S. Elevation:				
Date drilling completed: 2810 SKV		961-5210 4-6938 (fax)	E-log #:				
		·	L				
State Law requires that this rep	State Law requires that this report be prepared by the driller in detail and filed with the Department within						
30 days of completion of drilling Well Owner Inform	g of the well.	Well	Location				
Owner Name Stephen Flet			" Longitude <b>CSS</b> 46,480,				
Mailing Address: Cap Fletc			ne): Conventional Survey,				
		USGS quad, Hand-held	GPS, Survey-grade GPS				
Vancleave, M	5 39565 E Zip Code St 1/4 NW 1/4 Sec 15		Twn755 Rng#8W				
Telephone No. <u>228</u> ) 341-03	•	Distance Direction 7/2 Miles NW	Nearest Town of Varcleave				
Well Data							
Purpose of Well (circle one Home Industrial Public Supply Irrigation Fish Culture Other:							
Date well drilling started: Date well drilling completed: Date well drilling completed:							
If flowing, method of flow regulation: ValveOther (describe)							
Static Water Level: 55 feet above of below kircle one) land surface Date measured: 12/8/10							
Method of Measurement (circle one) steel tape electric tape air line other:							
Hole depth: 810 FT. Well depth: 810 FT. Well grouted to a depth of 10 feet							
Type of grout (circle one): Cement	Bentonite Mix						
Casing length: 790 feet Casing diameter: 3 inches Type of casing: PVC							
Screen length:							
Screen slot size: 406 inches Setting depth: From 790 feet to 810 feet							
Type of completion (circle all applicable): Gravel packed Underreamed Telescoped Open hole Natural Development							
Other (describe):							
Top of lap pipe or reduction in casing: feet. If telescoped or more than one screen, describe on back of page							
Logs run (circle all applicable) No log run Electric Gamma Ray Density Sonic Neutron Other:							
Name of organization running log(s): N/A							
I certify that the well was drilled, constructed, and completed in accordance with all applicable requirements of the Mississippi							
Department of Environmental Quality and/or the Mississippi Department of Health regulations and state laws.							
Jack Kidgdell C	1-472	Jack	Ridgeler				
Print Name of Water Well Contractor and License No.		Water Well Contractor					

Ground Level	

Description of Formations Encountered	From	То
TOPSOIL	0	يد
Gray Clay w Streaks of Sana,	a	48
Gray Coarse Sand w/ Peagrave	48	76
Blue Clay	76	186
Gray Medium tolinises and	186	<u>alo</u>
Blueclay W/Streaks of Sand	SIO	axe
Gray Coarse Sand	783	317
Blue clay	313	
Gray Coarse Sanch	663	720
Blue Clay Wistreaks ex- canq	MO	DY.
Gray Coarse Sand w/ Peagrave	750	טוא
	<b> </b>	
	}	
	1	
	<del> </del>	
	<u> </u>	
		-
	<del> </del>	
	<del>                                     </del>	

If more than one screen, show location of each on sketch

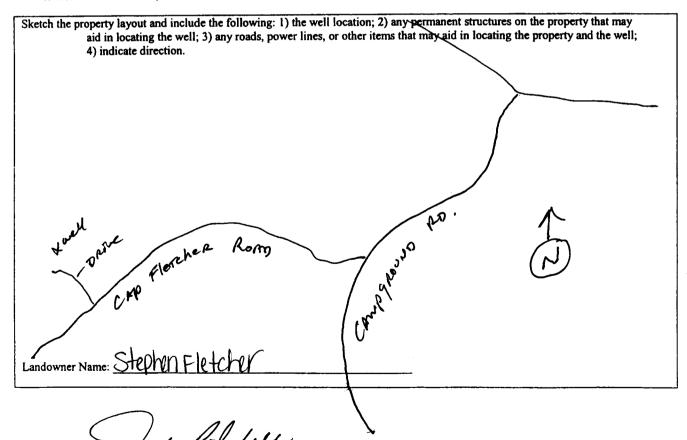

Signature of Water Well Contractor

RECEIVED

DEC 1 6 2010

BY: OLWR

STATE WELL REPORT						
Permit Driller COOST WATER LANGE SKV.  Date completed: [2] 8 [10]	Part 2 Pump Installer's Completion Report Mississippi Department of Environmental Quality Office of Land and Water Resources P.O. Box 10631 Jackson, MS 39289-0631 (601) 961-5210 (601) 354-6938 (fax)		For Office Use Only:  Aquifer:  Well #:  Elevation:			
This report should be prepared by the pump installer in detail and filed with the Department within 30 days of the						
installation of pump.		Well Location				
Owner Name: Stephen Fletcher		Latitude 30 36'0, 43 Longitude: 088°46'40.80				
Mailing Address: CapFletc	MINCI.	Method of Lat/Long (circle one): Conventional Survey,				
VONC Peave MS 3955  City Slate Zip Code  Telephone No. 28 341-0379		USGS quad, Hand-held GPS, Survey-grade GPS  56 1/4 NW 1/4 Sec 15 Twn 755 Rng R8 W  Distance Direction Nearest Town  7/2 Miles NW of Varaclesse				
relephone ivo.	·····					
Pump Type Circle one		ľ	wer Type Fircle one			
Air Lift Jet	Submersible	Diesel Engine Gasolin	ne Engine Natural Gas			
Bucket Piston	Turbine	Electric Motor Hand	Tractor PTO			
Centrifugal Rotary	Flowing Well	Windmill Other	(specify):			
Other (specify):		Horse Power Rating of Motor:				
Date Pump Installed: 12/9/10		Setting Depth: 80 FT. DOP Pipe fact				
Rated Pump Capacity: 12	_Gallons Per Minute	Number of Stages: 2				
Pump Test Data		Method of Measuring Water Level				
Date Well Tested: 12/9/10			ircle one			
Static Water Level (A): 55 Feet Below Land Surface		Air Line Electric Measuring Line Steel Tape				
Pumping Water Level (B):Feet	Pumping Water Level (B): Feet Below Land Surface Other (specify):					
Drawdown [(B) – (A)]: NA Feet	Below Land Surface	For flowing well, measured shut in head:feet				
Test Pumping Rate: 12	_Gallons Per Minute	Well yielded GPM with a drawdown of				
Duration of Pump Test (minimum 4 hours)	:hours	NA feet after	NA hours of pumping			

Print Name of Pump Installer and License No. (if applicable)

I HEREBY CERTIFY that the above statements are true to the best of my knowledge.

Print Name of Pump Installer and License No. (if applicable)

Signature of Pump Installer

RECEIVE

DEC 1 6 2010 BY: OLWR