State W	ell Report				
P	art 1				
Mississippi Departmen					
P.O.E	Box 10631				
Jackson, M	IS 39289-0631 L. S. Elevation: 961-5210				
Date drilling completed. (601) 35	E-log #:				
State Law requires that this report be prepared by the driller in detail and filed with the Department within 30 days of completion of drilling of the well.					
Weil Owner Information	Well Location				
Owner Name Paul Allen	Latitude 30 . 31 . 78 " Longitude 88 . 43 . 411 "				
Mailing Address: 18299 Larue Rd	Method of Lat/Long (circle one): Conventional Survey, 47				
	USGS quad, Hand-held GPS, Survey-grade GPS				
Ocean Springs, MS 37565 City State Zip Code	NW 1/4 Sec X30K- wn 55 Rng . 2W				
Telephone No. 008 334-2036	Distance Direction Nearest Town 1/2 Miles 50 JTH of LARUE				
Weil I	Data				
Purpose of Well (circle one) Home Industrial Public Supply	Irrigation Fish Culture Other:				
Date well drilling started:					
If flowing, method of flow regulation: Valve NA Other (d					
Static Water Level:					
Method of Measurement (circle one) steel tape electric tape air line other:					
Hole depth: 512 FT. Well depth: 512 FT.	Well grouted to a depth of feet				
Type of grout (circle one): Cement Bentonite Mix					
Casing length: <u>502</u> feet Casing diameter: <u>2</u> inches Type of casing: <u>PVC</u>					
Screen length: 10_feet Screen diameter: 2 inches Type of screen: PVC					
Screen slot size: <u>•006</u> inches Setting depth: From <u>502</u> feet to <u>5/2</u> feet					
Type of completion (circle all applicable): Gravel packed Underreamed Telescoped Open hole Natural Development					
Top of lap pipe or reduction in casing: feet. If telescoped or more than one screen, describe on back of page					
Logs run (circle all applicable) No log run Electric Gamma Ray Density Sonic Neutron Other:					
Name of organization running log(s): NA					
I certify that the well was drilled, constructed, and completed in accordance with all applicable requirements of the Mississippi Department of Environmental Quality and/or the Mississippi Department of Health regulations and state laws.					
Tack Ridadall 0 1172					
Print Name of Water Well Contractor and License No.	- REPENIER				
This rate of water wen Contractor and License No.	Signature of Water Well Continued JEIVED				

BY: OLWR


39 E196

if well telescopes please sketch below and show depths.

Ground Level

Description of For	mations Encountered	From	10
Topsoil		0	9
orange lay		a	10
orange Coarts	esand	10	23
manae clay		S	40
Emy Clay		40	75
Brown Coor	seSand	75	90
Phys clay		90	725
GrayMediud	a Coarse Sand,	1/55	184
Blue Claywe	Streaks of Sand	124	ial
DIVECTION	Since Sand	Lai	27
Bray Tealur			ua
		<u> </u>	
· · · · · · · · · · · · · · · · · · ·			
		i	
	· · · · · · · · · · · · · · · · · · ·		

If more than one screen, show location of each on sketch

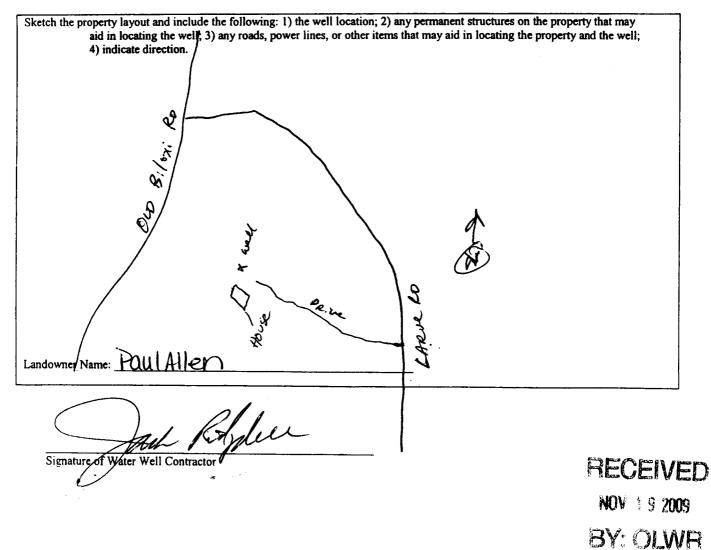

STATE W	STATE WELL REPORT					
County: Jackson Permit #: Driller Cast Water Wellsky 10/20/09 County: Jackson, 10/20/09 County: Jackson, 10/20/00 County: Jackso	Part 2 's Completion Report nt of Environmental Quality and Water Resources Box 10631 MS 39289-0631 1) 961-5210 354-6938 (fax) and filed with the Department within 30 days of the					
installation of pump.	Well Location					
Well Owner Information Owner Name: Paul Allen Mailing Address: 18299 Larue Rd. <u>Ocean Springs Ms 37565</u> City State Zip Code Telephone No. 008334-2036	Latitude: 30°31' 718 Longitude 088°43'44/" Method of Lat/Long (circle one): Conventional Survey, USGS quad, Hand-held GPP, Survey-grade GPS					
Pump Type Circle one	Power Type Circle one					
Air Lift Jet Submersible	Diesel Engine Gasoline Engine Natural Gas					
Bucket Piston Turbine	Electric Motor Hand Tractor PTO					
Centrifugal Rotary Flowing Well	Windmill Other (specify):					
Other (specify):	Horse Power Rating of Motor: 2 HP					
Date Pump Installed: 10130/09 Rated Pump Capacity: 9 Gallons Per Minute	Setting Depth://20FT.Droppipereet Number of Stages:					
Pump Test Data	Method of Measuring Water Level					
Date Well Tested: 10/30/09 Static Water Level (A): 100 Feet Below Land Surface Pumping Water Level (B): <u>N/A</u> Feet Below Land Surface	Air Line Electric Measuring Line Steel Tape Other (specify):					
Drawdown [(B) – (A)]:Feet Below Land Surface	For flowing well, measured shut in head:					
Test Pumping Rate:Gallons Per Minute Duration of Pump Test (minimum 4 hours):hours	Well yielded GPM with a drawdown of N/A feet after N/A hours of pumping					
I HEREBY CERTIFY that the above statements are true to the best of TACK Richtell 0-472 Print Name of Pump Installer and License No. (if applicable)	of my knowledge. Signature of Pump Installer RECEIVE					

B Y:	138	1	1
MY:		_VV	1000
212	15 M 181	No. 13	